



November 23, 1998

**CUST ID No.170200** 

FRANK G. PLETCHER AE-3 LTD ARCHITECTS & ENGINEERS 205 W. HIGHLAND AV., SUITE 302 MILWAUKEE, WI 53203

RE: CONDITIONAL APPROVAL APPROVAL EXPIRES: 11/23/1999

ATTN: Buildings & Structures INSPECTOR

MUNICIPAL CLERK VILLAGE OF BROWN DEER 4800 W GREEN BROOK DR MILWAUKEE WI 53223-2406

Identification Numbers

Transaction ID No. 189227

Site ID No. 607995

Please refer to both identification numbers, above, in all correspondence with the agency.

SITE:

Site ID: 607995

MILWAUKEE County, Village of BROWN DEER; 4000 W BROWN DEER RD, BROWN DEER 53209

Facility: GUARANTY BANK SSB 4000 W BROWN DEER RD, BROWN DEER 53209

FOR:

Description: Ch 54 Alteration-OFFICES

Object Type: Building Object Regulated Object ID No.: 435105

Description: Ch. 54 Alteration-OFFICES

Object Type: HVAC System Regulated Object ID No.: 435129

Description: Ch. 54 Alteration-OFFICES

Object Type: Lighting Regulated Object ID No.: 435130

Completely Sprinklered

Area of Alteration: 6,680 sq.ft.

The submittal described above has been reviewed for conformance with applicable Wisconsin Administrative Codes and Wisconsin Statutes. The submittal has been CONDITIONALLY APPROVED. The owner, as defined in chapter 101.01(10), Wisconsin Statutes, is responsible for compliance with all code requirements.

The following conditions shall be met during construction or installation and prior to occupancy or use:

ILHR 50.155 This structure is indicated as being fully protected by an automatic fire sprinkler system (see NFPA 13). This approval does not include a review of the system. The owner shall have and make available upon request by the department a copy of the reports documenting the acceptability of the completed system (see NFPA 13-1989, sections 1-10 and 1-11). The automatic fire sprinkler system plans shall be updated in order properly address the conditionally approved building alteration.

ILHR 63.50(4) Provide automatic lighting shut off controls per this code section. The code exempts the first 5,000 sq.ft. of alteration space. As indicated this alteration consists of 6, 680 sq.ft. The shut-off controls would only be required in the areas of alteration.

ILHR 64.31 Provide ducts designed to promote unrestricted air flow. Flex duct, if installed, shall not extend more than 14 ft.

ILHR 64.53(1) HVAC system balancing shall be performed, and a report shall be made available to the department upon request.

ILHR 64.53(3) All operating manuals concerning the HVAC equipment and its maintenance shall be presented to the owner as is appropriate with the alteration.





NOTE: Four (4) sets of lighting calculations were sent in with the 4 sets of reflective lighting plans. Only 1 of the 4 sets of lighting calculations are required when 4 sets of reflective ceiling plans are included. Designer of the lighting plans is reminded that the lighting calculations, when submitted, must have an original stamp and signature. Only 1 set of lighting calculations were received that contained both the original professional stamp and the designer's original signature. That set will be kept on file at Dept. of Commerce. The other 3 sets of calculations are being returned.

A copy of the approved plans, specifications and this letter shall be on-site during construction and open to inspection by authorized representatives of the Department, which may include local inspectors. All permits required by the state or the local municipality shall be obtained prior to commencement of construction/installation/operation.

Inquiries concerning this correspondence may be made to me at the telephone number listed below, or at the address on this letterhead.

Sincerely.

RANDALL R. DAHMEN P.E.

**ENGINEERING CONSULTANT-HVAC** 

Integrated Services

(608)266-3162 , M-F 7:45AM - 4:30PM

RDAHMEN@COMMERCE.STATE.WI.US

DATE RECEIVED 11/20/1998

FEE REQUIRED \$ 580.00 FEE RECEIVED \$ 580.00

BALANCE DUE \$ 0.00


WiSMART code: 7648

cc: BETTY J WIESE, BUILDING INSPECTOR, (414) 228-6956, MONDAY, 7:45 A.M. - 4:30 P.M.

PAUL RAMSTACK

**GUARANTEE BANK SSB** 

JOHN PROMERSBERGER PRO-TEL INC

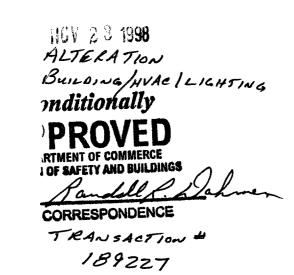



Architects Engineers

Construction Managers

205 W. HIGHLAND AVENUE
MILWAUKEE, WI 53203
FAX: 414/276-8448
PHONE: 414/276-8375


# GUARANTY BANK

GUARANTY BANK

TENANT SPACE, FIRST FLOOR
4000 W BROWN DEER ROAD
BROWN DEER, WISCONSIN

PROJECT NO. 98047

COVER

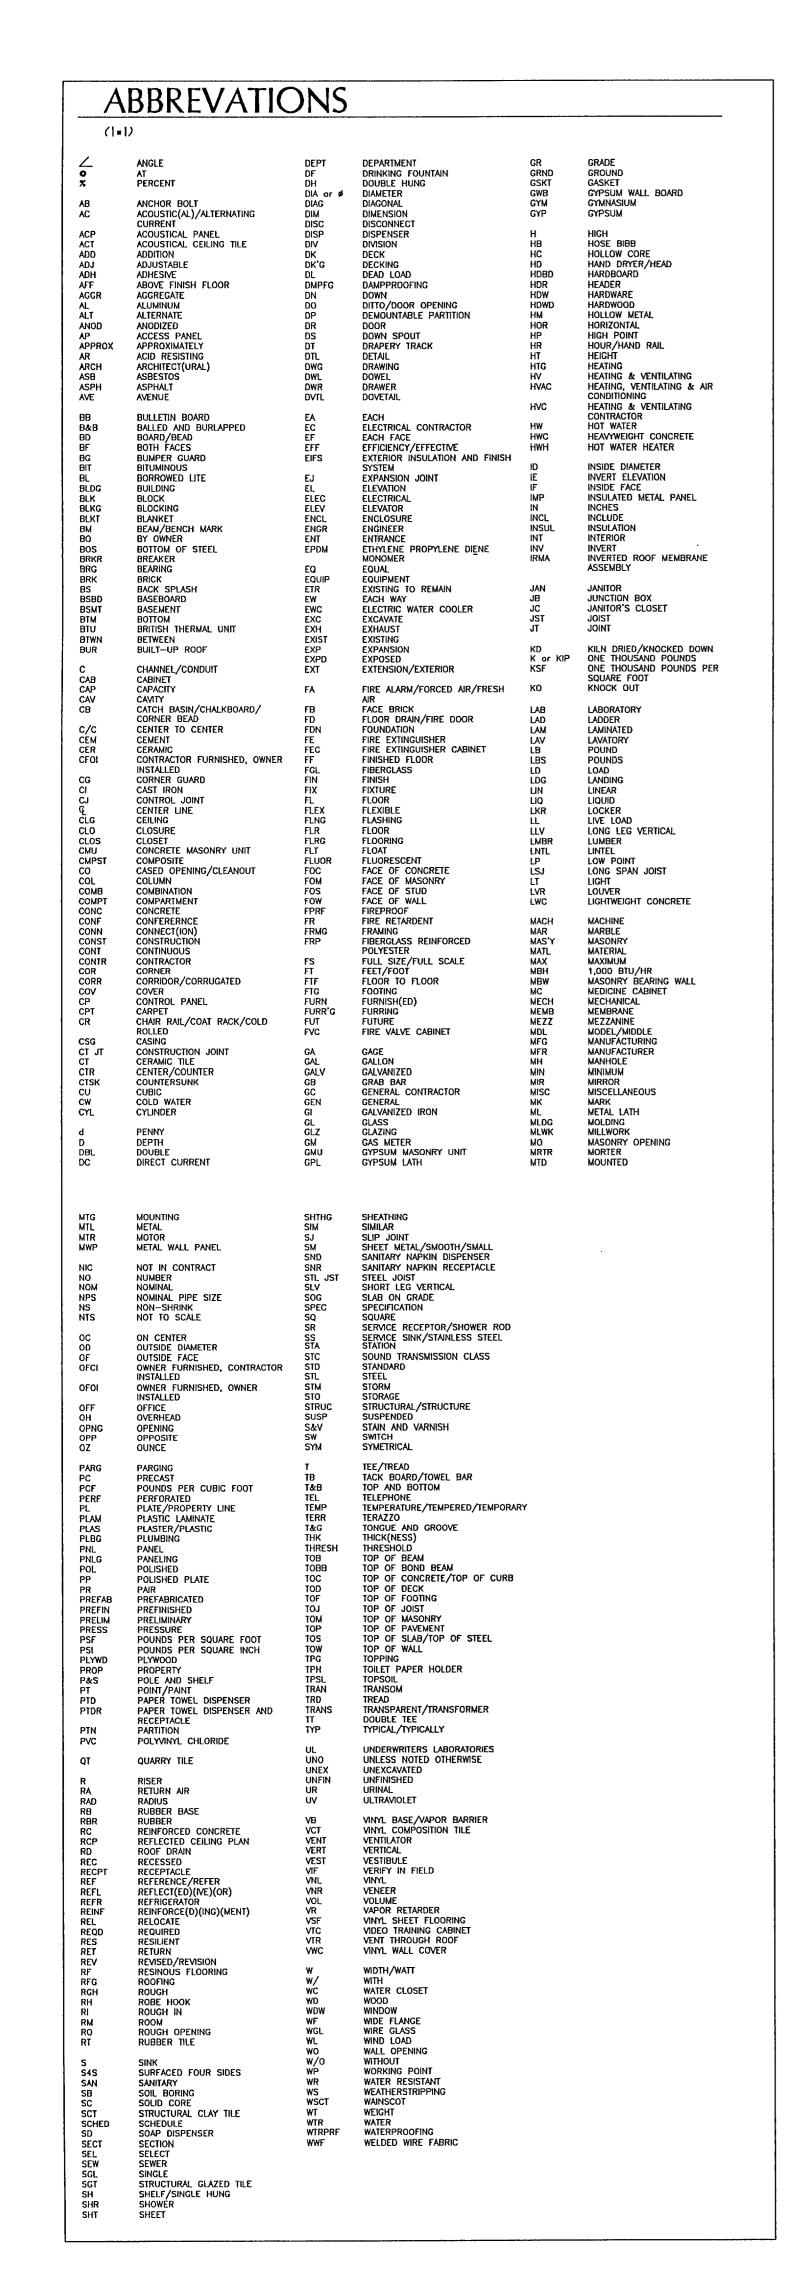

### SYMBOLS & CONVENTIONS (|=|) - DIRECTION OF CUT DRAWING NORTH - DRAWING NUMBER (SEE SITE PLAN FOR TRUE NORTH) BUILDING SECTION REFERENCE -- SHEET NUMBER ON WHICH METAL STUD WALL DRAWING WILL BE FOUND EXISTING WALL TO REMAIN SECTION DETAIL REFERENCE EXISTING ITEMS TO BE REMOVED WALL SECTION REFERENCE WINDOW PLAN DETAIL DOOR & DOOR NUMBER REFERENCE EXISTING DOOR TO REMAIN INTERIOR ELEVATION REFERENCE COLUMN GRID WALL TYPE REFERENCE ROOM NAME & NUMBER KEYED NOTE DWG BLOCK TITLE ELEVATION MARKER 1/8' = 1'-0" COMMUNICATION OUTLET OUTLINES AREA REVISION AFFECTED BY TELEPHONE REVISION DUPLEX OUTLET 2x4 FLUSH FLUOR IN 2x4 CLG GRID

8'-0'

101

CLG HEIGHT

ROOM NO

### MATERIAL LEGEND

(1=1) EARTH SAND, PLASTER, GROUT GRAVEL CONCRETE PRECAST CONCRETE CONCRETE BLOCK BRICK TERRAZZO RIGID INSULATION BATT INSULATION STEEL GYPSUM WALLBOARD WOOD, FINISHED WOOD BLOCKING WOOD SHIM PLYWOOD ACOUSTICAL PANELS

CUT LIMESTONE

COMPRESSIBLE FILLER

SEALANT

### **PRINCIPALS**

(1=1)

### CONTRACTOR

REDMOND CONSTRUCTION W228 N727 WESTMOUND DRIVE WAUKESHA, WISCONSIN 53186 (414) 549-9600 FAX (414) 549-1725

BUILDING OWNER

**GUARANTY BANK** 4000 W BROWN DEER ROAD BROWN DEER, WISCONSIN 53209-1221 (414) 362-4787 FAX (414) 362-4888

### ARCHITECT

AE-3 LTD. 205 W. HIGHLAND AVENUE, SUITE 302 MILWAUKEE, WISCONSIN 53203 (414) 276-8375 FAX (414) 276-8448

### STRUCTURAL ENGINEER

AE-3 LTD. 205 W. HIGHLAND AVENUE, SUITE 302 MILWAUKEE, WISCONSIN 53203 (414) 276-8375 FAX (414) 276-8448

### PLUMBING ENGINEER

PROTEL MECHANICAL CONTRACTORS, INC 1790 S JOHNSON ROAD NEW BURLIN, WISCONSIN 53146 (414) 549-8709 FAX (414) 549-8488

### HVAC ENGINEER

PROTEL MECHANICAL CONTRACTORS, INC 1725 S JOHNSON ROAD NEW BURLIN, WISCONSIN 53146 (414) 549-8712 FAX (414) 545-8481

ELECTRICAL ENGINEER

SPECTRUM ELECTRIC, INC. 9730E N GRANVILLE ROAD MEQUON, WISCONSIN 53097 (414) 242-9790 FAX (414) 242-9763

### SHEET INDEX

(1=1)

NO. NAME COVER SHEET AD GENERAL INFORMATION

DI EXISTING/DEMO FLOOR PLAN

AI FLOOR PLAN REFLECTED CEILING PLAN


FURNITURE PLAN ROOM FINISH SCHEDULE


DOOR SCHEDULE DETAILS A5 EXISTING FLOOR PLAN

HVI HVAC FLOOR PLAN

ELECTRICAL DEMO PLAN

ELECTRICAL LIGHTING PLAN E3 ELECTRICAL POWER PLAN

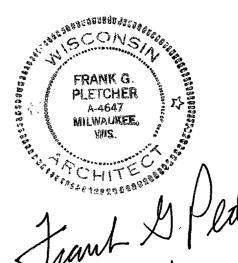

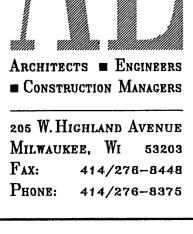

PROJECT  GUARANTY BANK  4000 W BROWN DEER ROAD BROWN DEER, WISCONSIN  PROJECT TYPE  LEGENDS	1 Holds. 4747210 0010
GUARANTY BANK 4000 W BROWN DEER ROAD BROWN DEER, WISCONSIN  PROJECT TYPE	
4000 W BROWN DEER ROAD BROWN DEER, WISCONSIN  PROJECT TYPE	PROJECT
PROJECT TYPE	GUARANTY BANK
	PROJECT TYPE
LEGENDS	
LEGENDS	
LEGENDS	
LEGENDS	
LEGENUS	
	LEGENDS

REVISIONS							
NO.	DATE	DESCRIPTION	CONST				
		•					
S	HEET	CONTENTS					


2HEE I	CONTE	
OFMERAL	IVIEODI (ATIONI	


98047

GENERAL INFORMATION

MISC. INFO	
------------	--

DATE: 11/13/98 PROJECT NO.

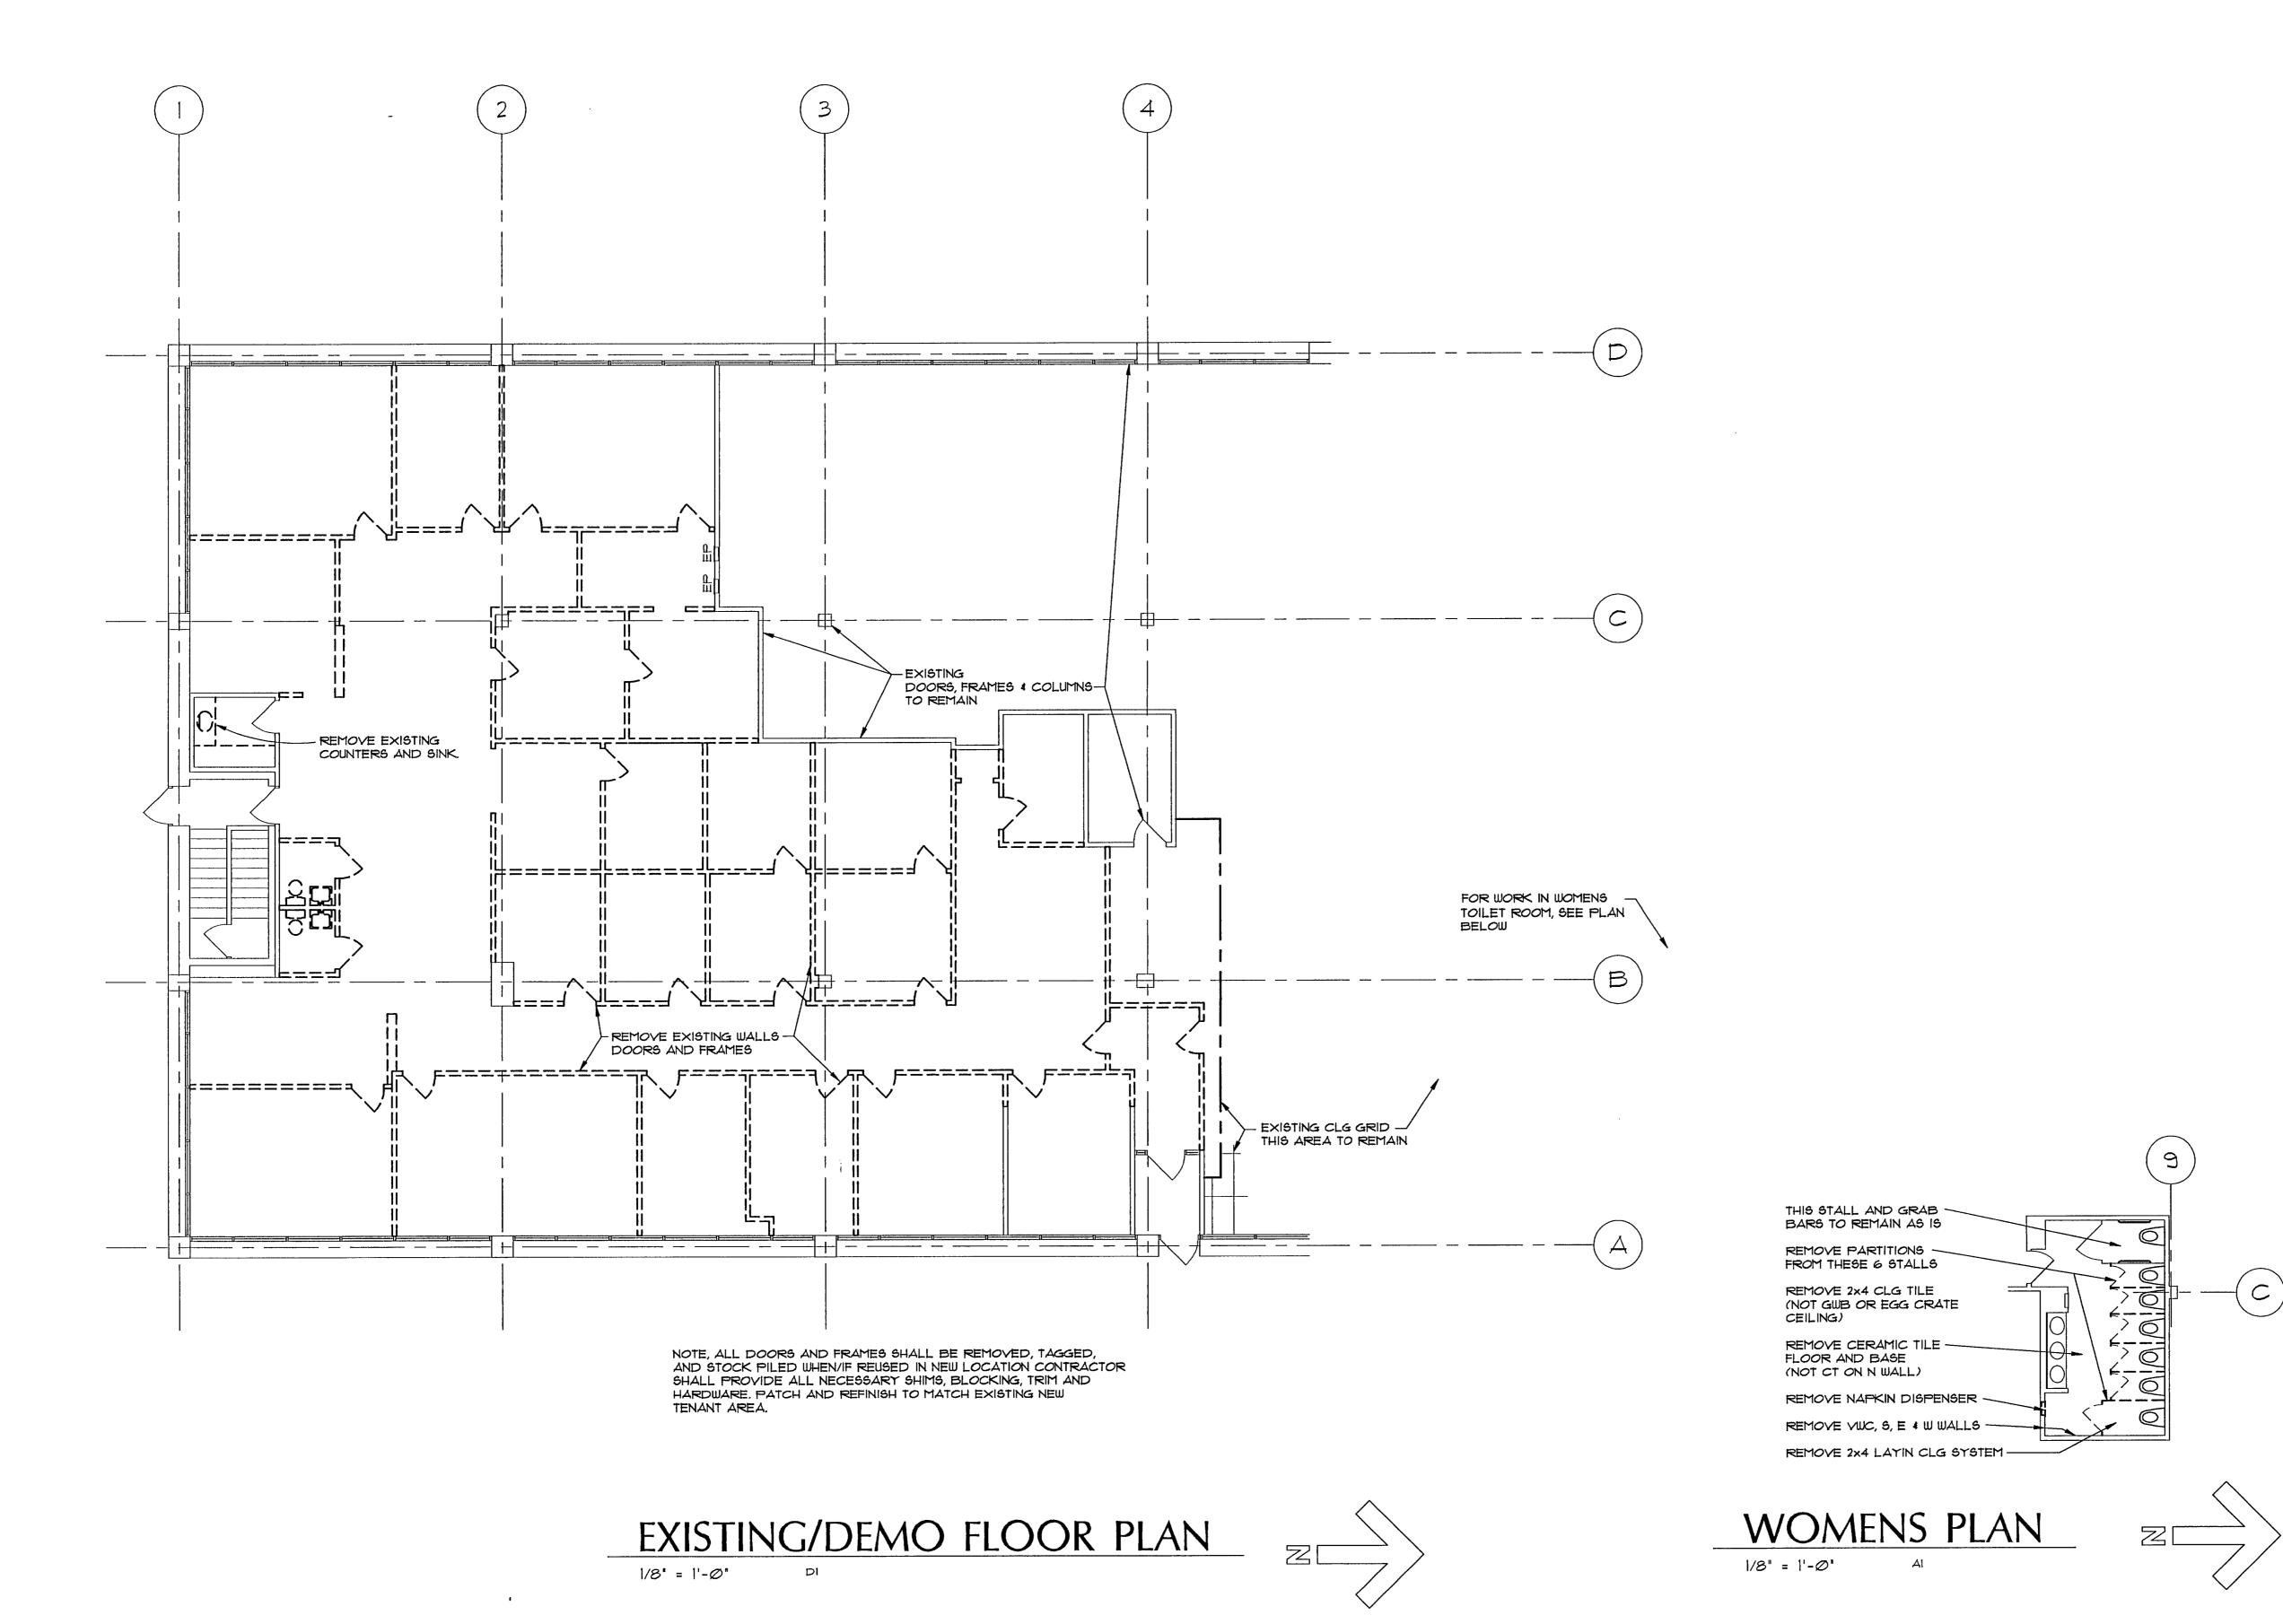

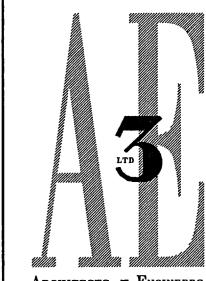

Architects Engineers ■ Construction Managers


205 W. Highland Avenue MILWAUKEE, WI 53203 FAX: 414/276-8448 Phone: 414/276-8375

PROJECT	
GUAF	ranty bank
	ROWN DEER ROAI DEER, WISCONSIN
PROJECT	TYPE
LEGENDS	
PATCH	NG WALL TO REMAIN I AND REPAIR AG/IF RED TO LOOK LIKE NEW
	NG ITEM TO BE REMOVED
PATCH	I SURROUNDING AREA
PATCH	
PATCH	I SURROUNDING AREA

NO.	DATE	DESCRIPTION	CONST
S	HEET	CONTENTS	
F)	KISTING	/DEMO FLOOR PLAN	

MISC. INFO

11/13/98 PROJECT NO.

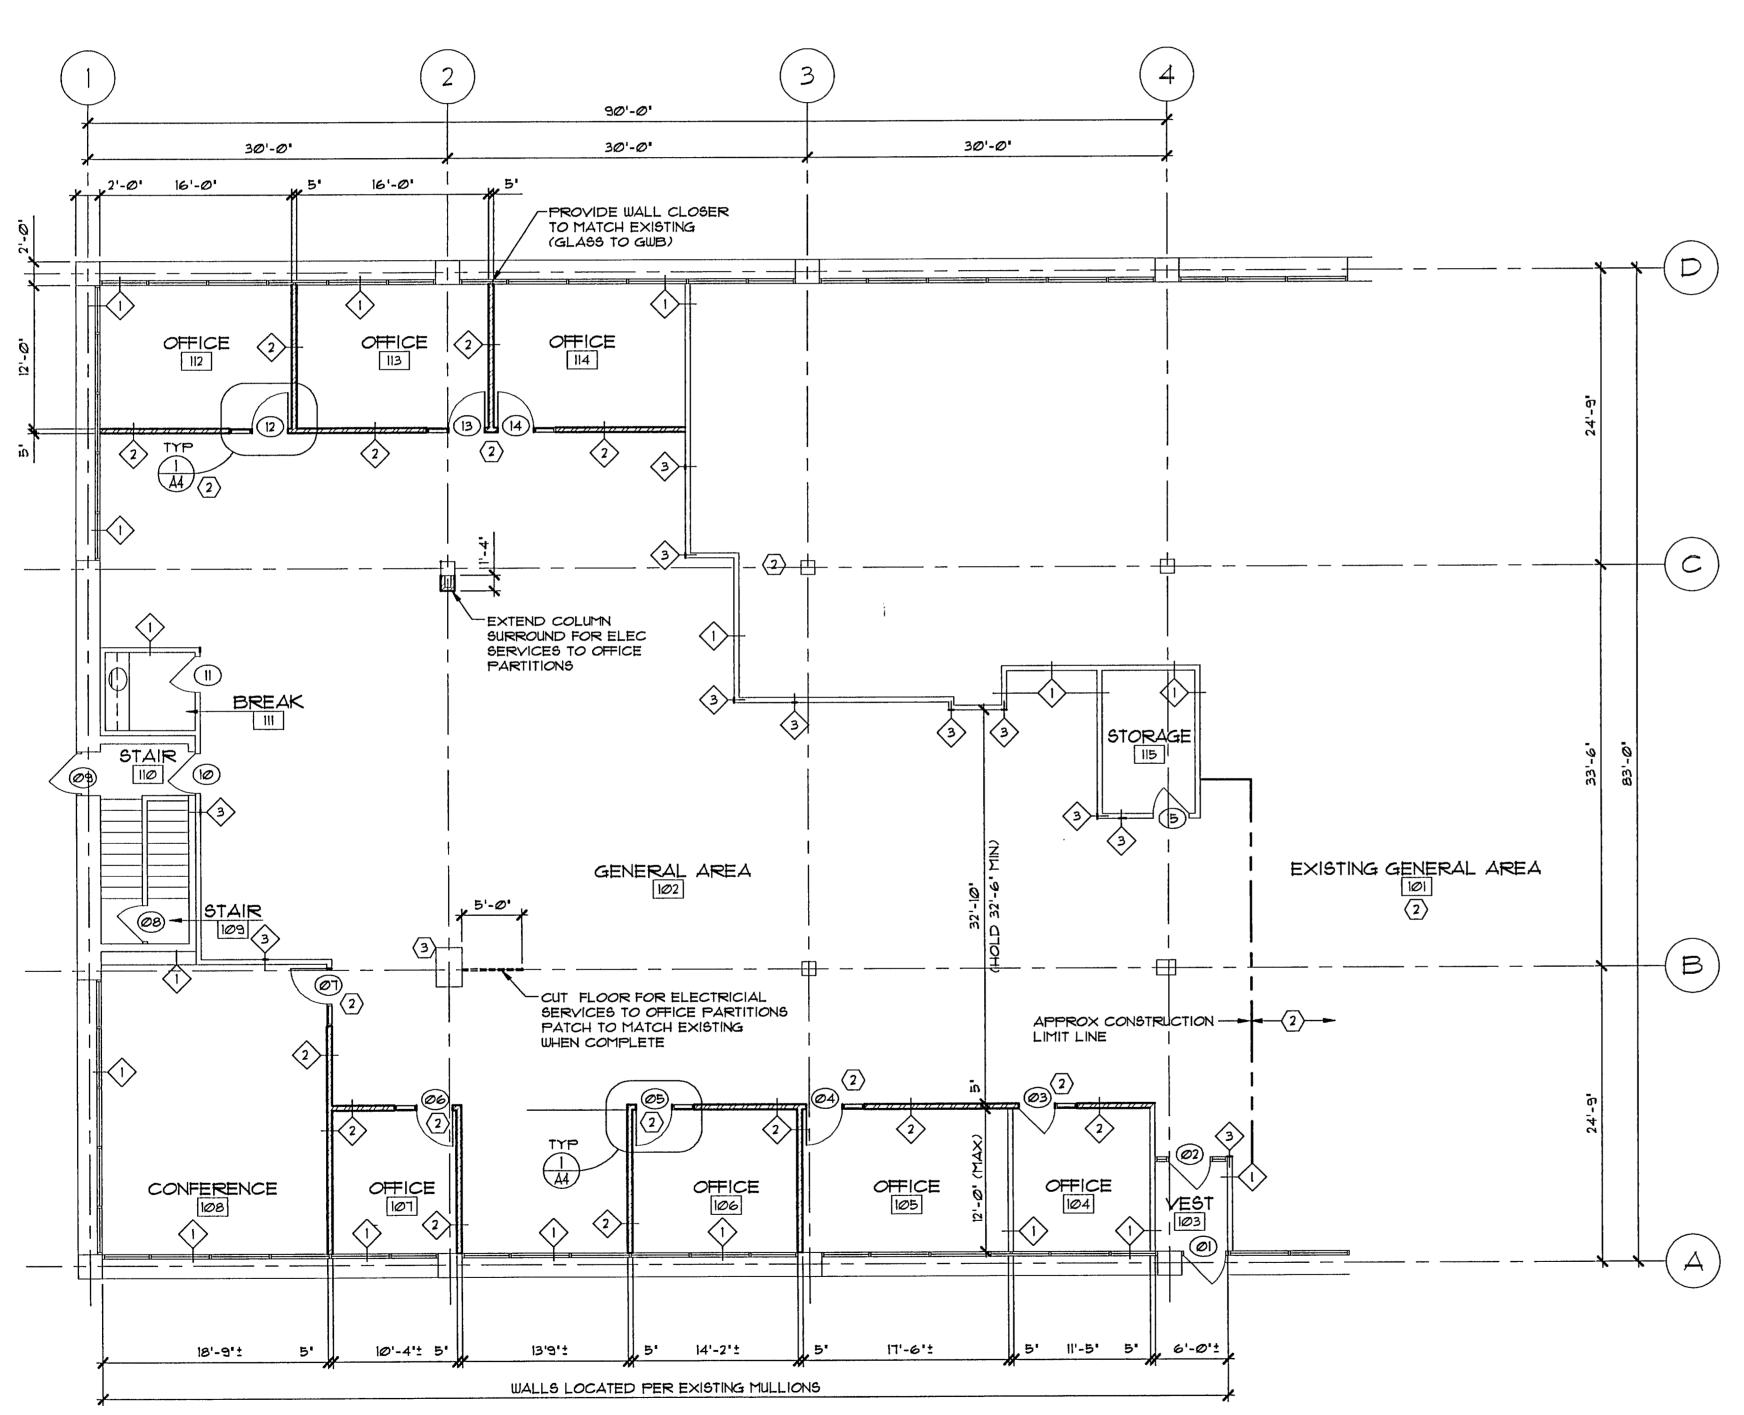



FLRPL

EXISTING WALL TO REMAIN. PATCH AS REQUIRED SO APPEARANCE MATCHES NEW.


3 5/8' METAL STUDS AT 16' OC WITH 5/8'
GYPSUM WALLBOARD BOTH SIDES, STUDS
GO FLOOR TO STRUCTURE ABOVE. GWB
FROM FLOOR TO 4' MIN ABOVE CEILING.
PROVIDE 4' SOUND BLANKET FLOOR TO 4'
MINIMUM ABOVE CEILING.


PATCH EXISTING WALL AS REQUIRED WHERE ANOTHER EXISTING WALL WAS REMOVED. APPEARANCE TO MATCH NEW.

### KEYED NOTES

FLRPLN

- SEE SHEET A4 FOR DOOR 4 SIDELIGHT DETAILS
- THIS AREA NOT IN CONTRACT UNLESS
  NOTED OTHERWISE OR UNLESS REQUIRED
  DUE TO WORK IN CONTRACT AREA.
  (WOMENS TOILET ROOM IN CONTRACT)
- MAKE COLUMN 2B AS SMALL AS POSSIBLE. KEEP A RECTANGULAR SHAPE.

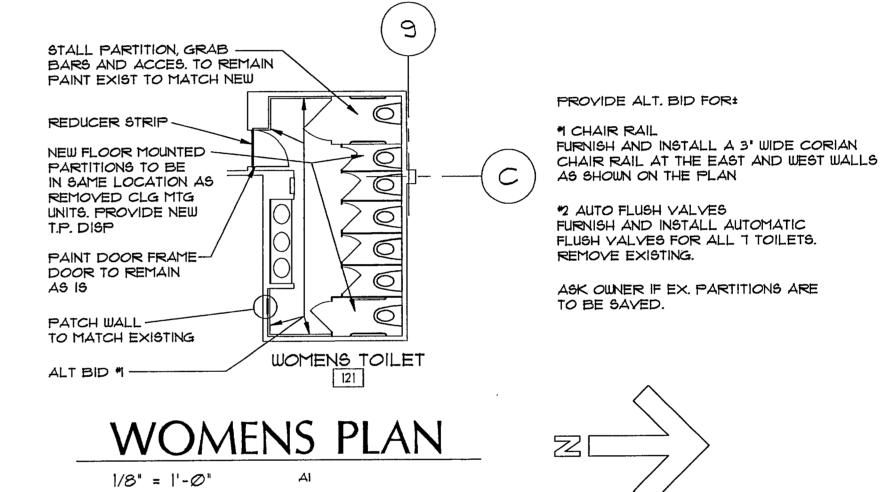

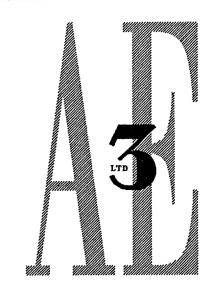

Architects Engineers

Construction Managers

205 W. HIGHLAND AVENUE
MILWAUKEE, WI 53203
FAX: 414/276-8448
PHONE: 414/276-8375

R	O	IE	C	T
	<b>-</b>	, –		

GUARANTY BANK 4000 W BROWN DEER ROAD BROWN DEER, WISCONSIN

PROJECT TYPE

**LEGENDS** 

**REVISIONS** 

NO.	DATE	DESCRIPTION	CONST
		- Laboratory	
S	HEET	CONTENTS	
Fl	OOR PL	_AN	

MISC. INFO

DATE: 11/13/98 PROJECT NO. 98047


A1


SHEET

FLOOR PLAN

1/8' = 1'-@'


AI

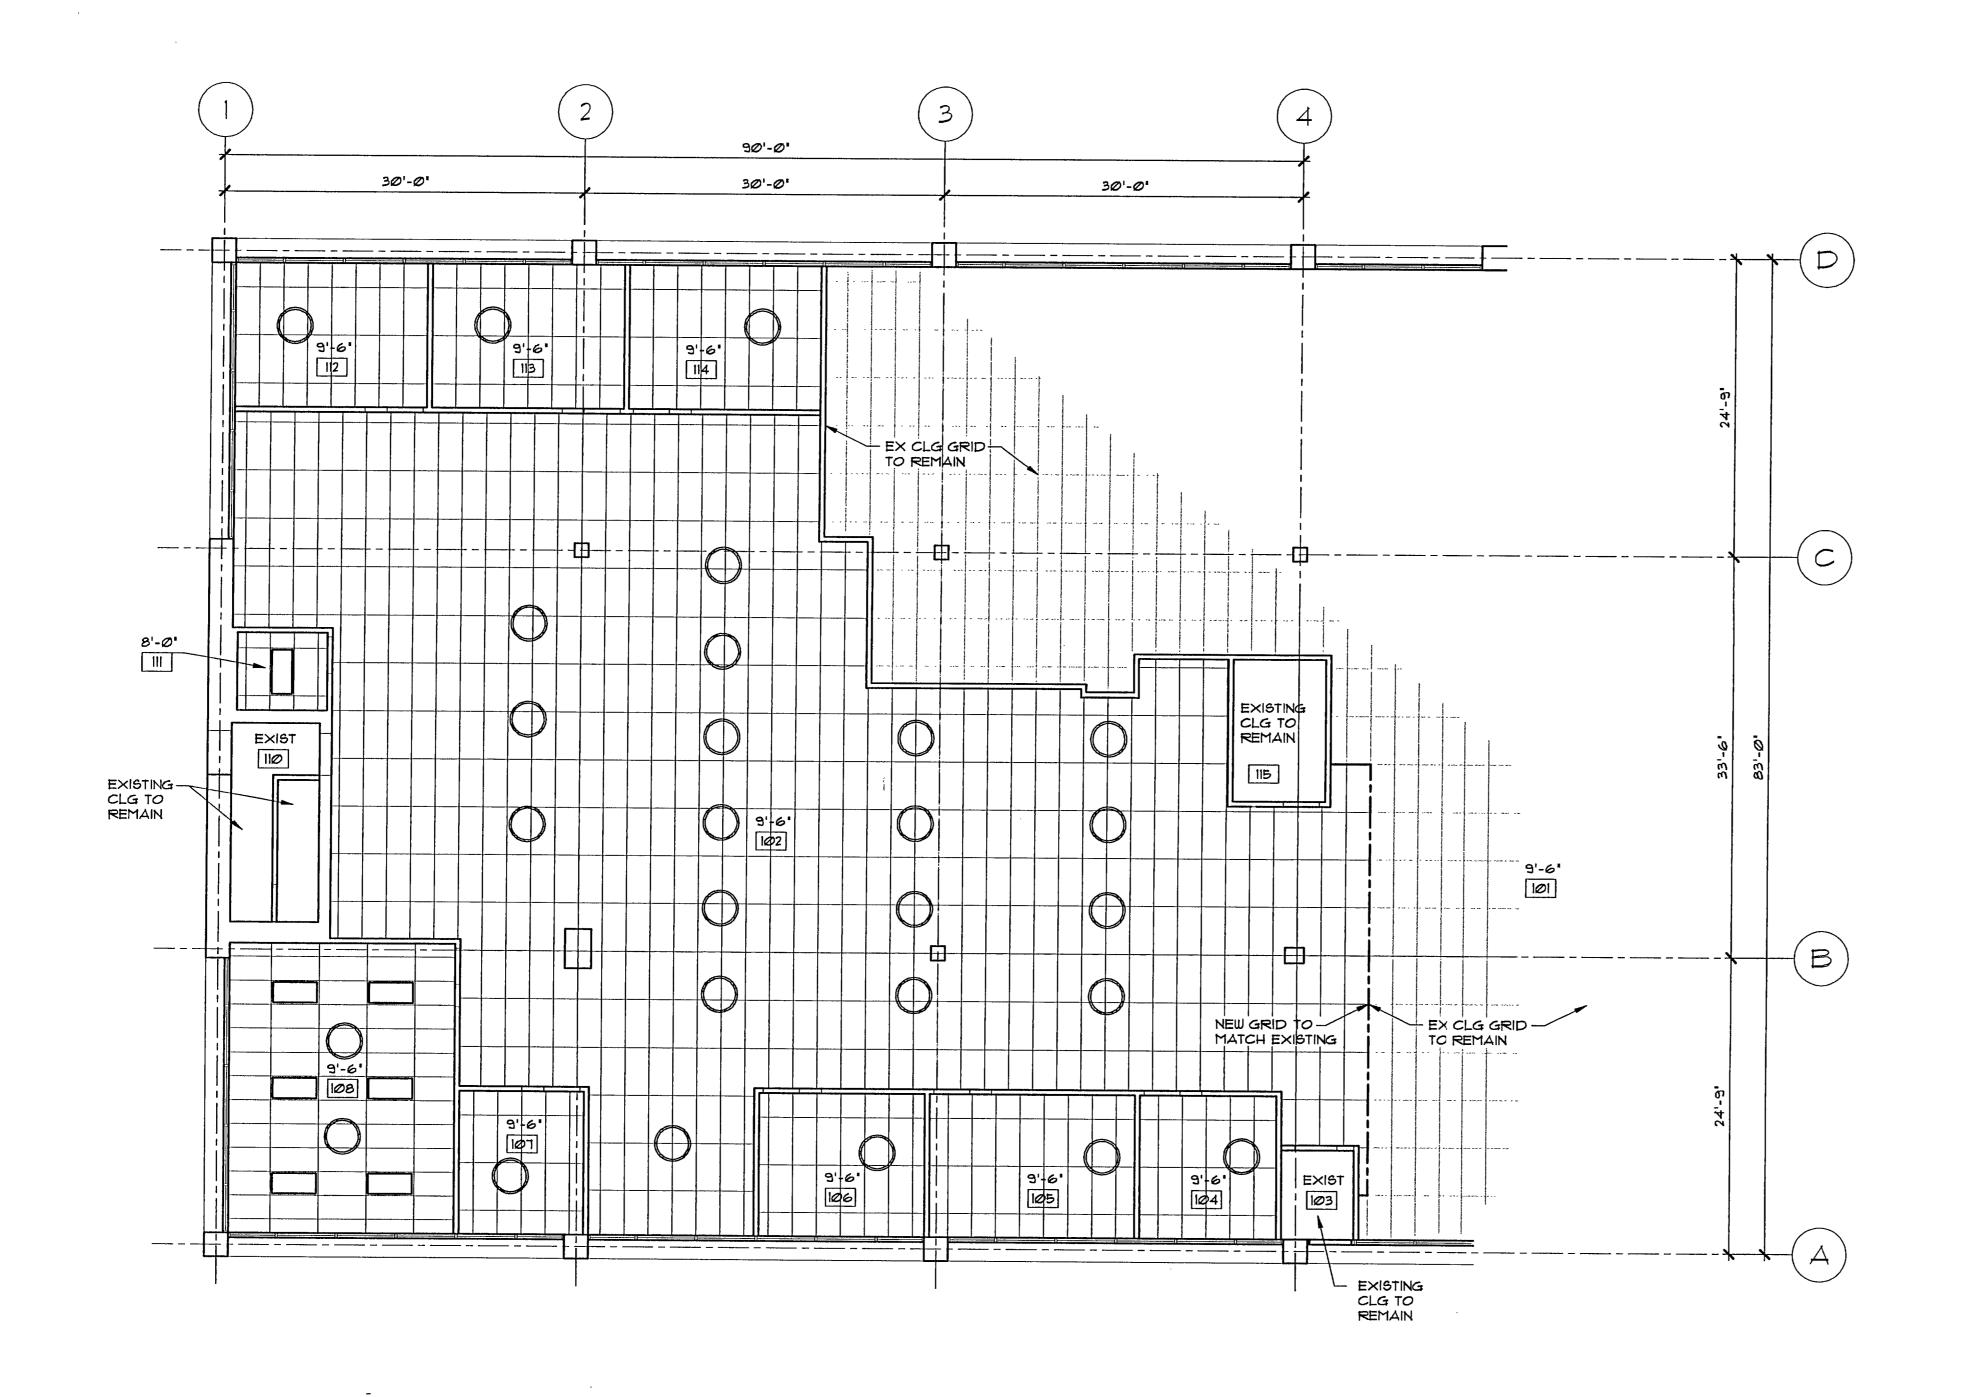


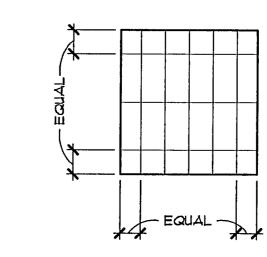


## TYP CLG GRID LAYOUT

1/8" = 1'-0"

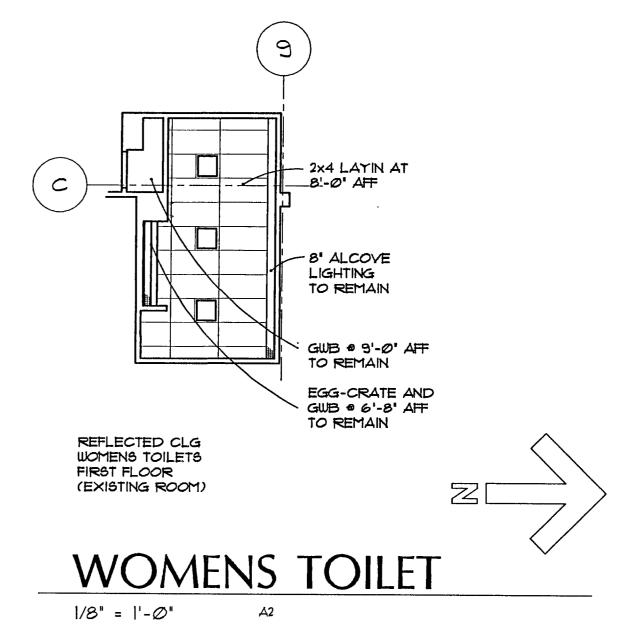

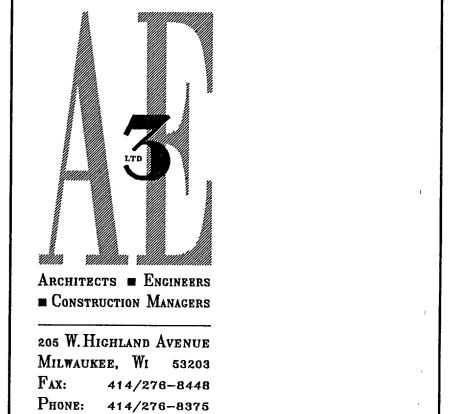

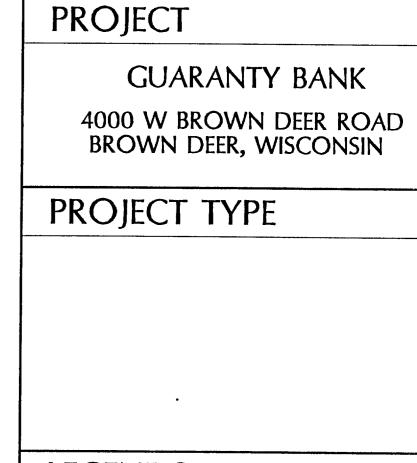



	•	1
LEGEND	S	
A	COMMUNICATION OUTLET	1
Δ	TELEPHONE	
Ф	DUPLEX OUTLET	
	REMOVE & REUSE 2x4 FLUSH FLUOR IN 2x4 CLG GRID	
	SUPPLY GRILLES	
-	EXISTING CEILING TILE & GRID	
9'-6 <b>'</b> 101	CLG HEIGHT ROOM NO	
0	LIGHTS SUPPLIED BY OWNER, INSTALLED BY CONTRACTOR (FINAL LOCATION TO BE DETERMINED AFTER FURNITURE PLAN IS FINALIZED)	

NO.	DATE	DESCRIPTION	CONST
		CONTENTS	
3		CONTENTS	

MISC. INFO SHEET 11/13/98 PROJECT NO.




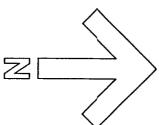


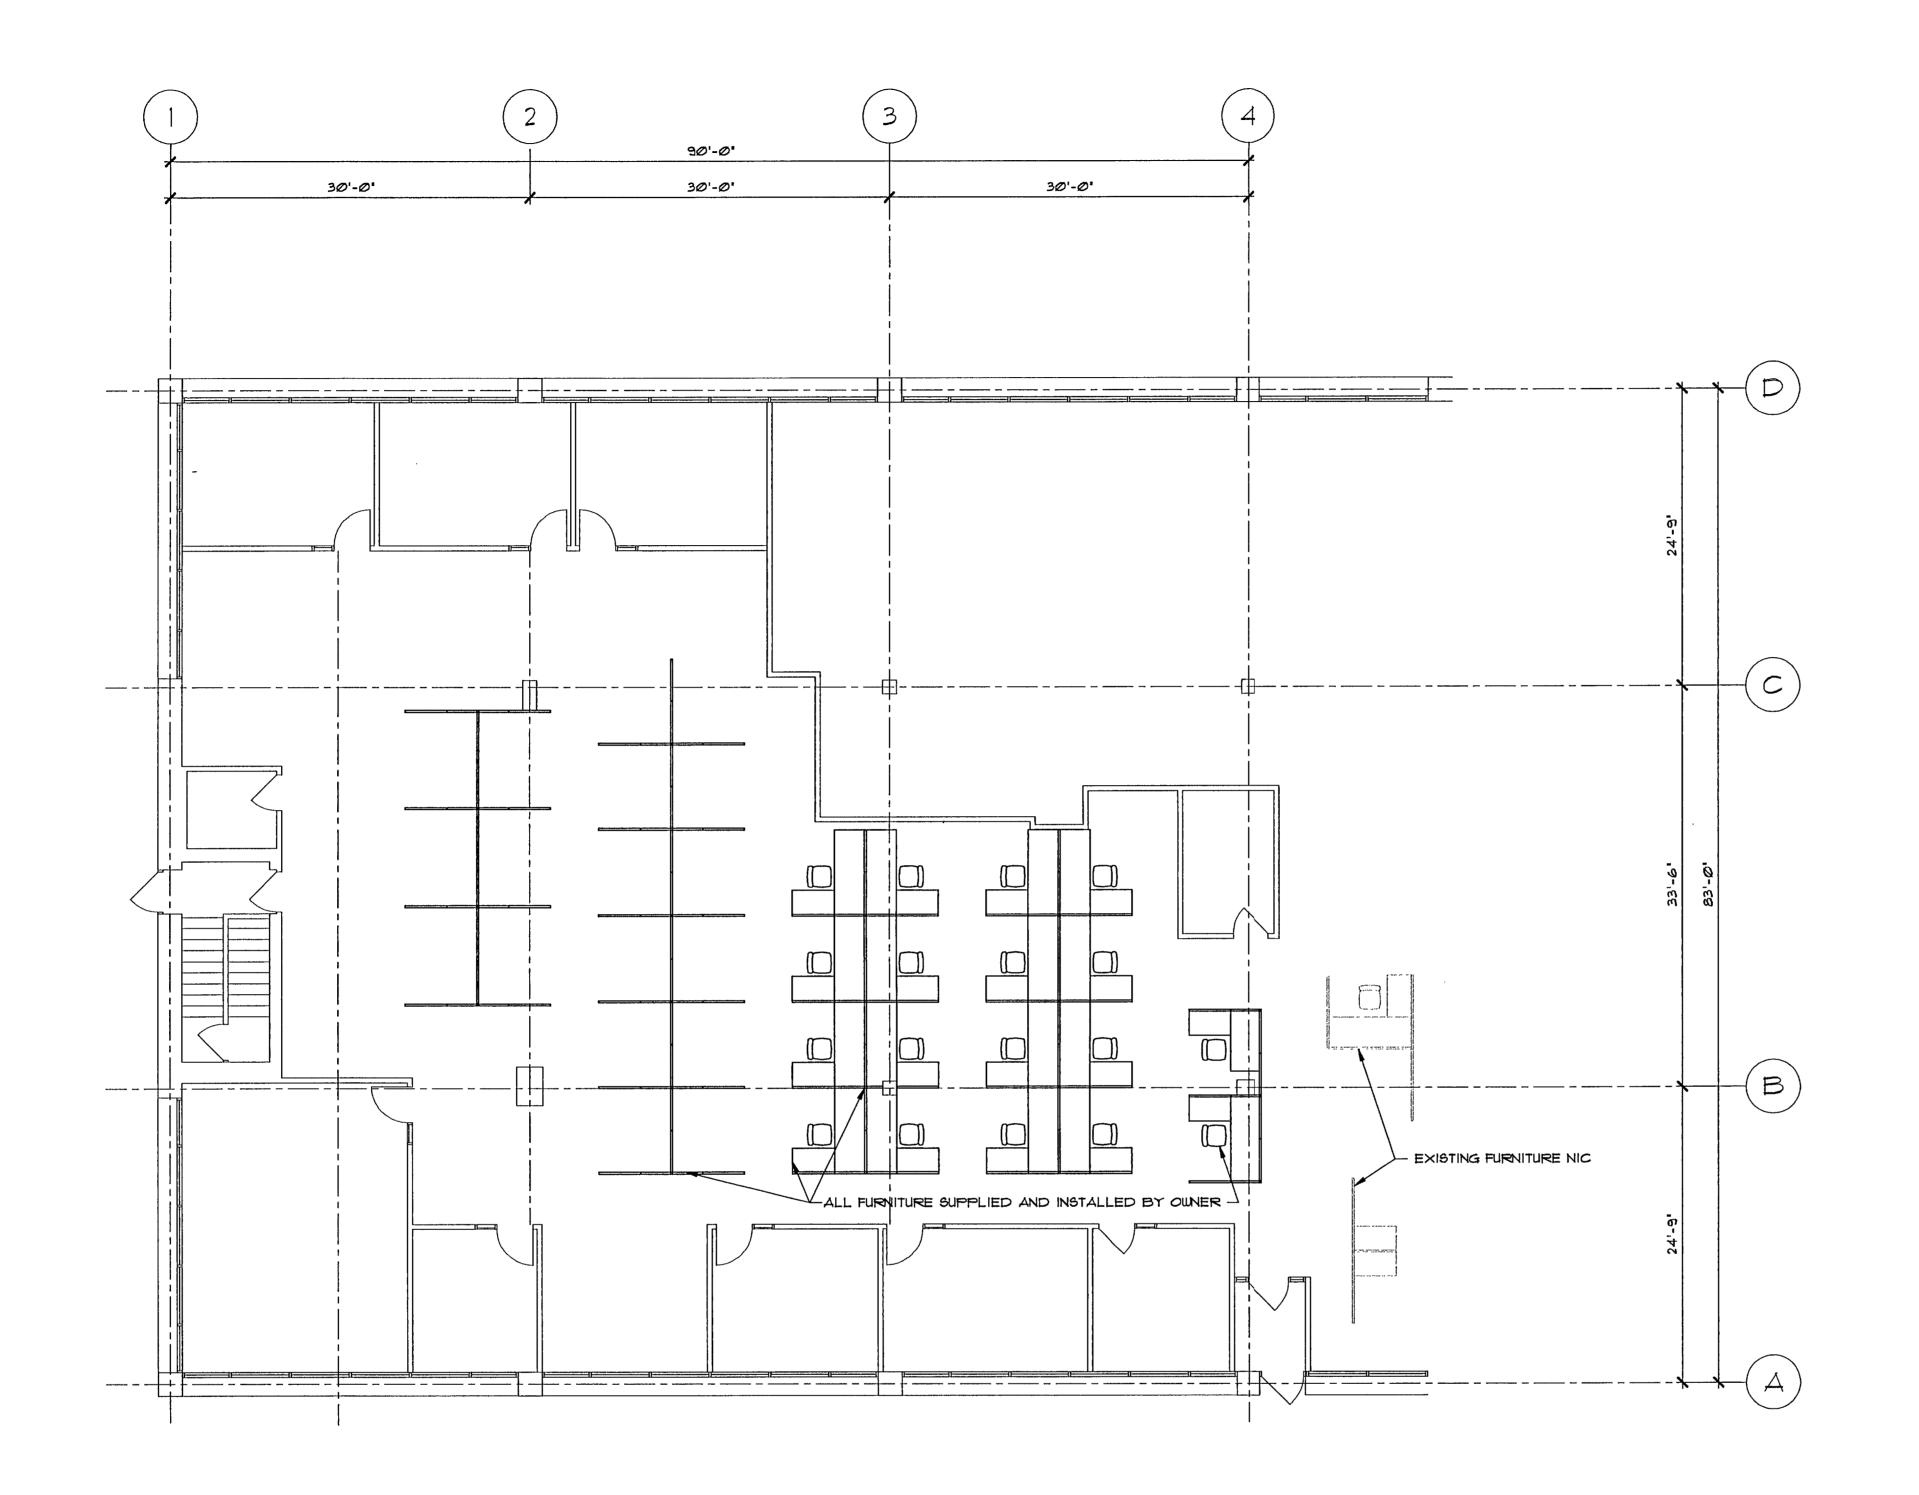

FURNITURE PLAN

1/8' = 1'-0' FURNPLAN

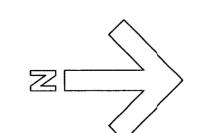


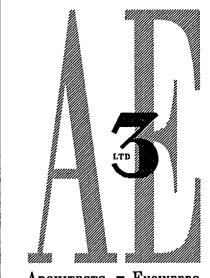


Architects Engineers
Construction Managers

205 W. HIGHLAND AVENUE
MILWAUKEE, WI 53203
FAX: 414/276-8448
PHONE: 414/276-8375


PROJECT		
GUARANT	Y BANK	
4000 W BROWN BROWN DEER,		
PROJECT TYP	'E	
		4
LEGENDS		
		• 1
		,
		,
REVISIONS		
NO. DATE DESCRIPTION		CONST
•		
		!
SHEET CONT	ENTS	
FURITURE PLAN		
MISC. INFO	SHEET	•
77115 01 11 11 0	- CIILLI	

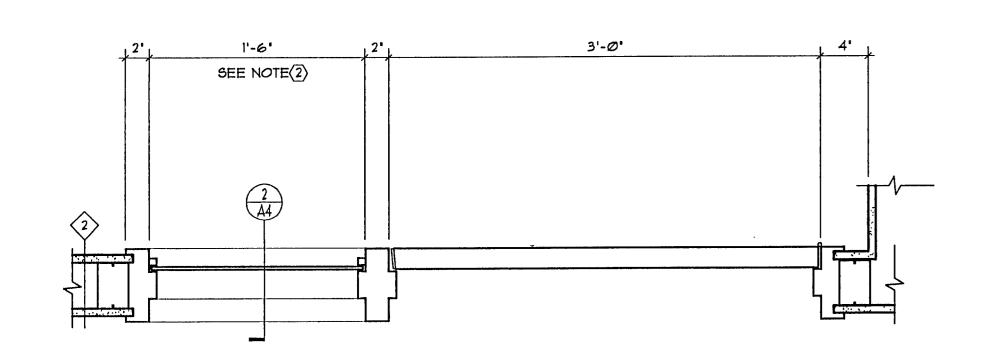

# HOLLOW METAL - DOOR @ SIDELIGHT

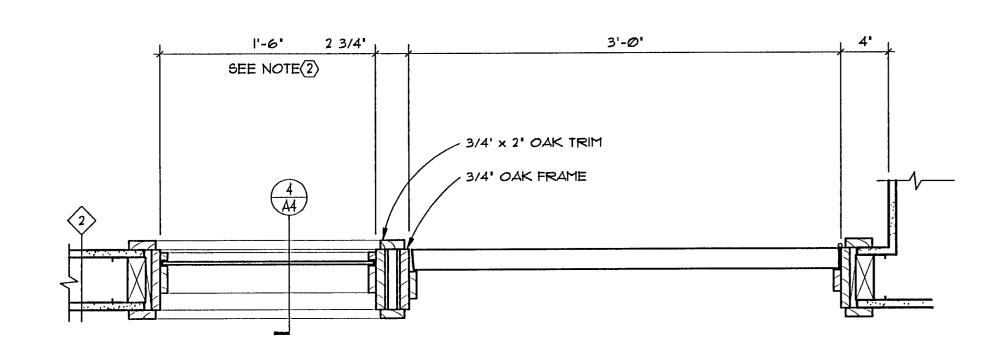


# WOOD - DOOR @ SIDELIGHT

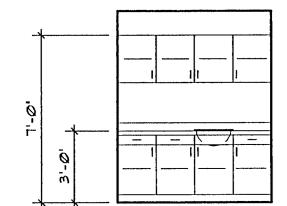


REMOVE EXISTING CABINETS. PROVIDE NEW LAM PLASTIC FINISHED (ALL SURFACES) CABINETS WITH PLASTIC PULLS, TRICOVE TOP AND CONCEALED


EL OF S WALL - BREAK ROOM 111

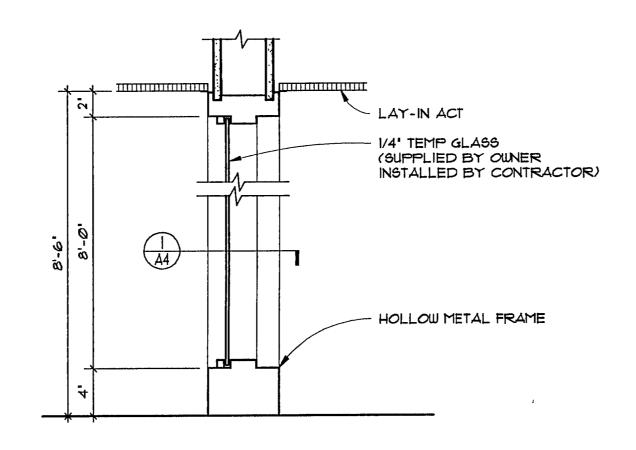

### SECTION @ HM SIDELIGHT

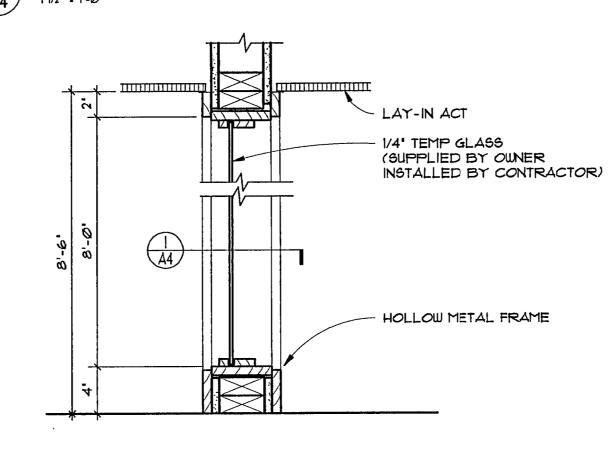

# SECTION @ WOOD SIDELIGHT

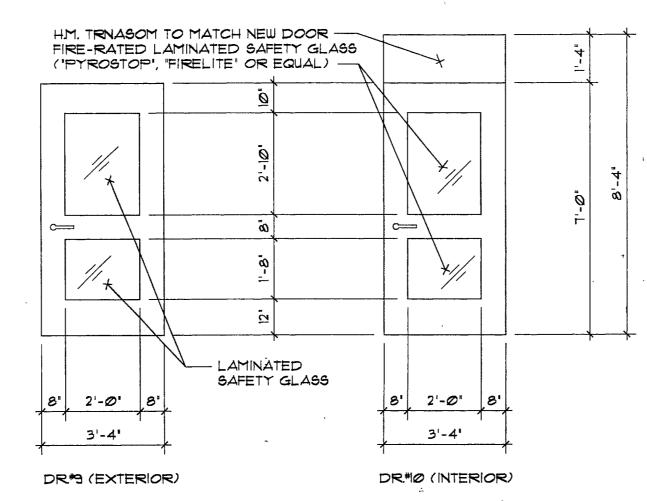

NEW DOORS @ NOS. 9 & 10

	ROOM FINISH SCHEDULE 3									
NO.	ROOM NAME	FLOOR	BASE	NORTH	EAST	SOUTH	WEST	CLG.	CLG. HT.	REMARKS
101	EXIST GENERAL AREA	EXIST	EXIST	EXIST	EXIST	EXIST	EXIST	EXIST	EXIST	
102	GENERAL AREA	CARPET	VINYL	GWB/PT	GWB/PT	GWB/PT	GWB/PT	ACT	9'-6"	2
103	VESTIBULE	EXIST	EXIST	EXIST	EXIST	EXIST	EXIST	EXIST	EXIST	
104	OFFICE	CARPET	VINYL	VIIC	VIIC	VIIC	MIC	ACT	9'-6'	
105	OFFICE	CARPET	VINYL	VIIC	VIIC	VIIC	VIIC	ACT	9'-6"	
106	OFFICE	CARPET	VINYL	VIIC	VIIC	VIIC	VWC	ACT	9'-6"	
107	OFFICE	CARPET	VINTL	VIIC	VIIIC	VIIC	VWC	ACT	9'-6'	
108	CONFERENCE	CARPET	VINYL	VIIC	VIIC	MC	VWC	ACT	9'-6'	
109	STAIR	EXIST	EXIST	EXIST	EXIST	EXIST	EXIST	EXIST	EXIST	
110	STAIR	EXIST	EXIST	EXIST	EXIST	EXIST	EXIST	EXIST	EXIST	
111	BREAK	VSF	VINYL	VIIC	VIIC	MIC	MC	ACT	8'-0'	
112	OFFICE	CARPET	VINYL	VIIC	VIIC	VIIC	VWC	ACT	9'-6'	
113	OFFICE	CARPET	VINYL	VIIC	VIIC	MIC	VWC	ACT	9'-6'	
114	OFFICE	CARPET	VINYL	VIIC	VIIC	VIIC	VWC	ACT	9'-6'	
115	STORAGE	EXIST	EXIST	EXIST	EXIST	EXIST	EXIST	EXIST	EXIST	
116-12	20 4	EXIST	EXIST	EXIST	EXIST	EXIST	EXIST	EXIST	EXIST	
121	WOMENS TOILET	5	5	6	6	6	6	٦	7	

- EXISTING GENERAL AREA. WORK THIS AREA NIC UNLESS OTHERWISE NOTED, OR REQUIRED TO FINISH CONTRACT WORK.
- GENERAL AREA. WORK THIS AREA TO MATCH EXISTING GENERAL AREA UNLESS OTHERWISE NOTED.
- ALL MATERIALS, FINISHES, ETC. TO MATCH EXISTING UNLESS OTHERWISE NOTED.
- REMOVE EXISTING CERAMIC TILE FLOOR & BASE, PROVIDE 12x12 TILE FLOOR AND BASE TO MATCH LOBBY
- REMOVE EXISTING 2x4 CEILING ® 8'-0" AFF. PROVIDE NEW 2x4 ® 8'-0". SEE REFL CLG PLAN FOR MORE INFO.

DR.		DOOR (4)					FRAME			
NO.	SIZE	TYPE	MATERIAL	GL/SIDELT	GRILL	FINISH	TYPE	MATERIAL	DETAIL	REMARKS
ØI	EXIST	EXIST	EXIST	EXIST	EXIST	EXIST	EXIST	EXIST	EXIST	NIC
Ø2	EXIST	EXIST	EXIST	EXIST	EXIST	EXIST	EXIST	EXIST	EXIST	NIC
Ø3	36x112x1 3/4	FLUSH	SC WOOD	2	'NA	54V	A		1 OR 3/A4	
<b>Ø</b> 4	36×112×1 3/4	FLUSH	SC WOOD	2	NA	SŧV	A		1 OR 3/A4	
Ø5	36×112×1 3/4	FLUSH	SC WOOD	2	NA	SŧV	A		1 OR 3/A4	
06	36x112x1 3/4	FLUSH	SC WOOD	2	NA	SŧV	A		1 OR 3/A4	
Ø7	36×112×1 3/4	FLUSH	SC WOOD	2	NA	54V	A		1 OR 3/A4	
08	EXIST	EXIST	EXIST	EXIST	EXIST	EXIST	EXIST	EXIST	EXIST	NIC
Ø9	3'-4" × 7'-0"	FLUSH	H.M.	( <del>5</del> )	NA	6	EXIST	EXIST	6/44	EXTERIOR
10	3'-4" × 8'-4"	FLUSH	H.M.	( <del>5</del> )	NA	6	EXIST	EXIST	6/44	1 1/2 HR (
11	EXIST	EXIST	EXIST	EXIST	EXIST	EXIST	EXIST	EXIST	EXIST	NIC
12	36×112×1 3/4	FLUSH	SC WOOD	2	NA	SAV	A		1 OR 3/A4	
13	36x112x1 3/4	FLUSH	SC WOOD	(2)	NA	54V	A		1 OR 3/A4	,
14	36×112×1 3/4	FLUSH	SC WOOD	(2)	;NA	SŧV	A		1 OR 3/A4	
15-21	EXIST	EXIST	EXIST	EXIST	EXIST	EXIST	EXIST	EXIST	EXIST	NIC


(1) CONTRACTOR MAY SUPPLY AND (3) ALL WOOD BLOKING TO INSTALL HOLLOW METAL OR

BE FIRE RETARDANT


5 SEE DETAIL 6/A4

1 1/2 HR RATED HARDWARE

WOOD FRAMES. (4) REUSE ALL EXISTING OAK DOORS. (6) PRIME & PAINT TO MATCH GC TO REPAIR AND REFINISH, AND EXISTING FRAME (2) 1'-6' SIDELIGHT MAY VARY. CONFIRM SIZE OF OWNER FUNISHED SUPPLY NEW HARDWARE GLASS BEFORE BUILDING FRAME

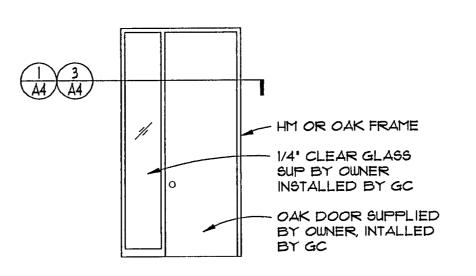

FRAME TYPE A

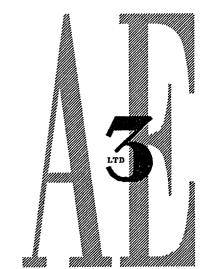

Architects 

Engineers ■ Construction Managers

205 W. Highland Avenue MILWAUKEE, WI 53203 FAX: 414/276-8448 Phone: 414/276-8375

### **PROJECT**

**GUARANTY BANK** 4000 W BROWN DEER ROAD BROWN DEER, WISCONSIN

### PROJECT TYPE

### **LEGENDS**

### **REVISIONS**


NO.	DATE	DESCRIPTION	CONST
		·	
S	HEET	CONTENTS	


ROOM FINISH SCHEDULE DOOR SCHEDULE **DETAILS** 

MISC. INFO


PROJECT NO.

11/13/98 98047

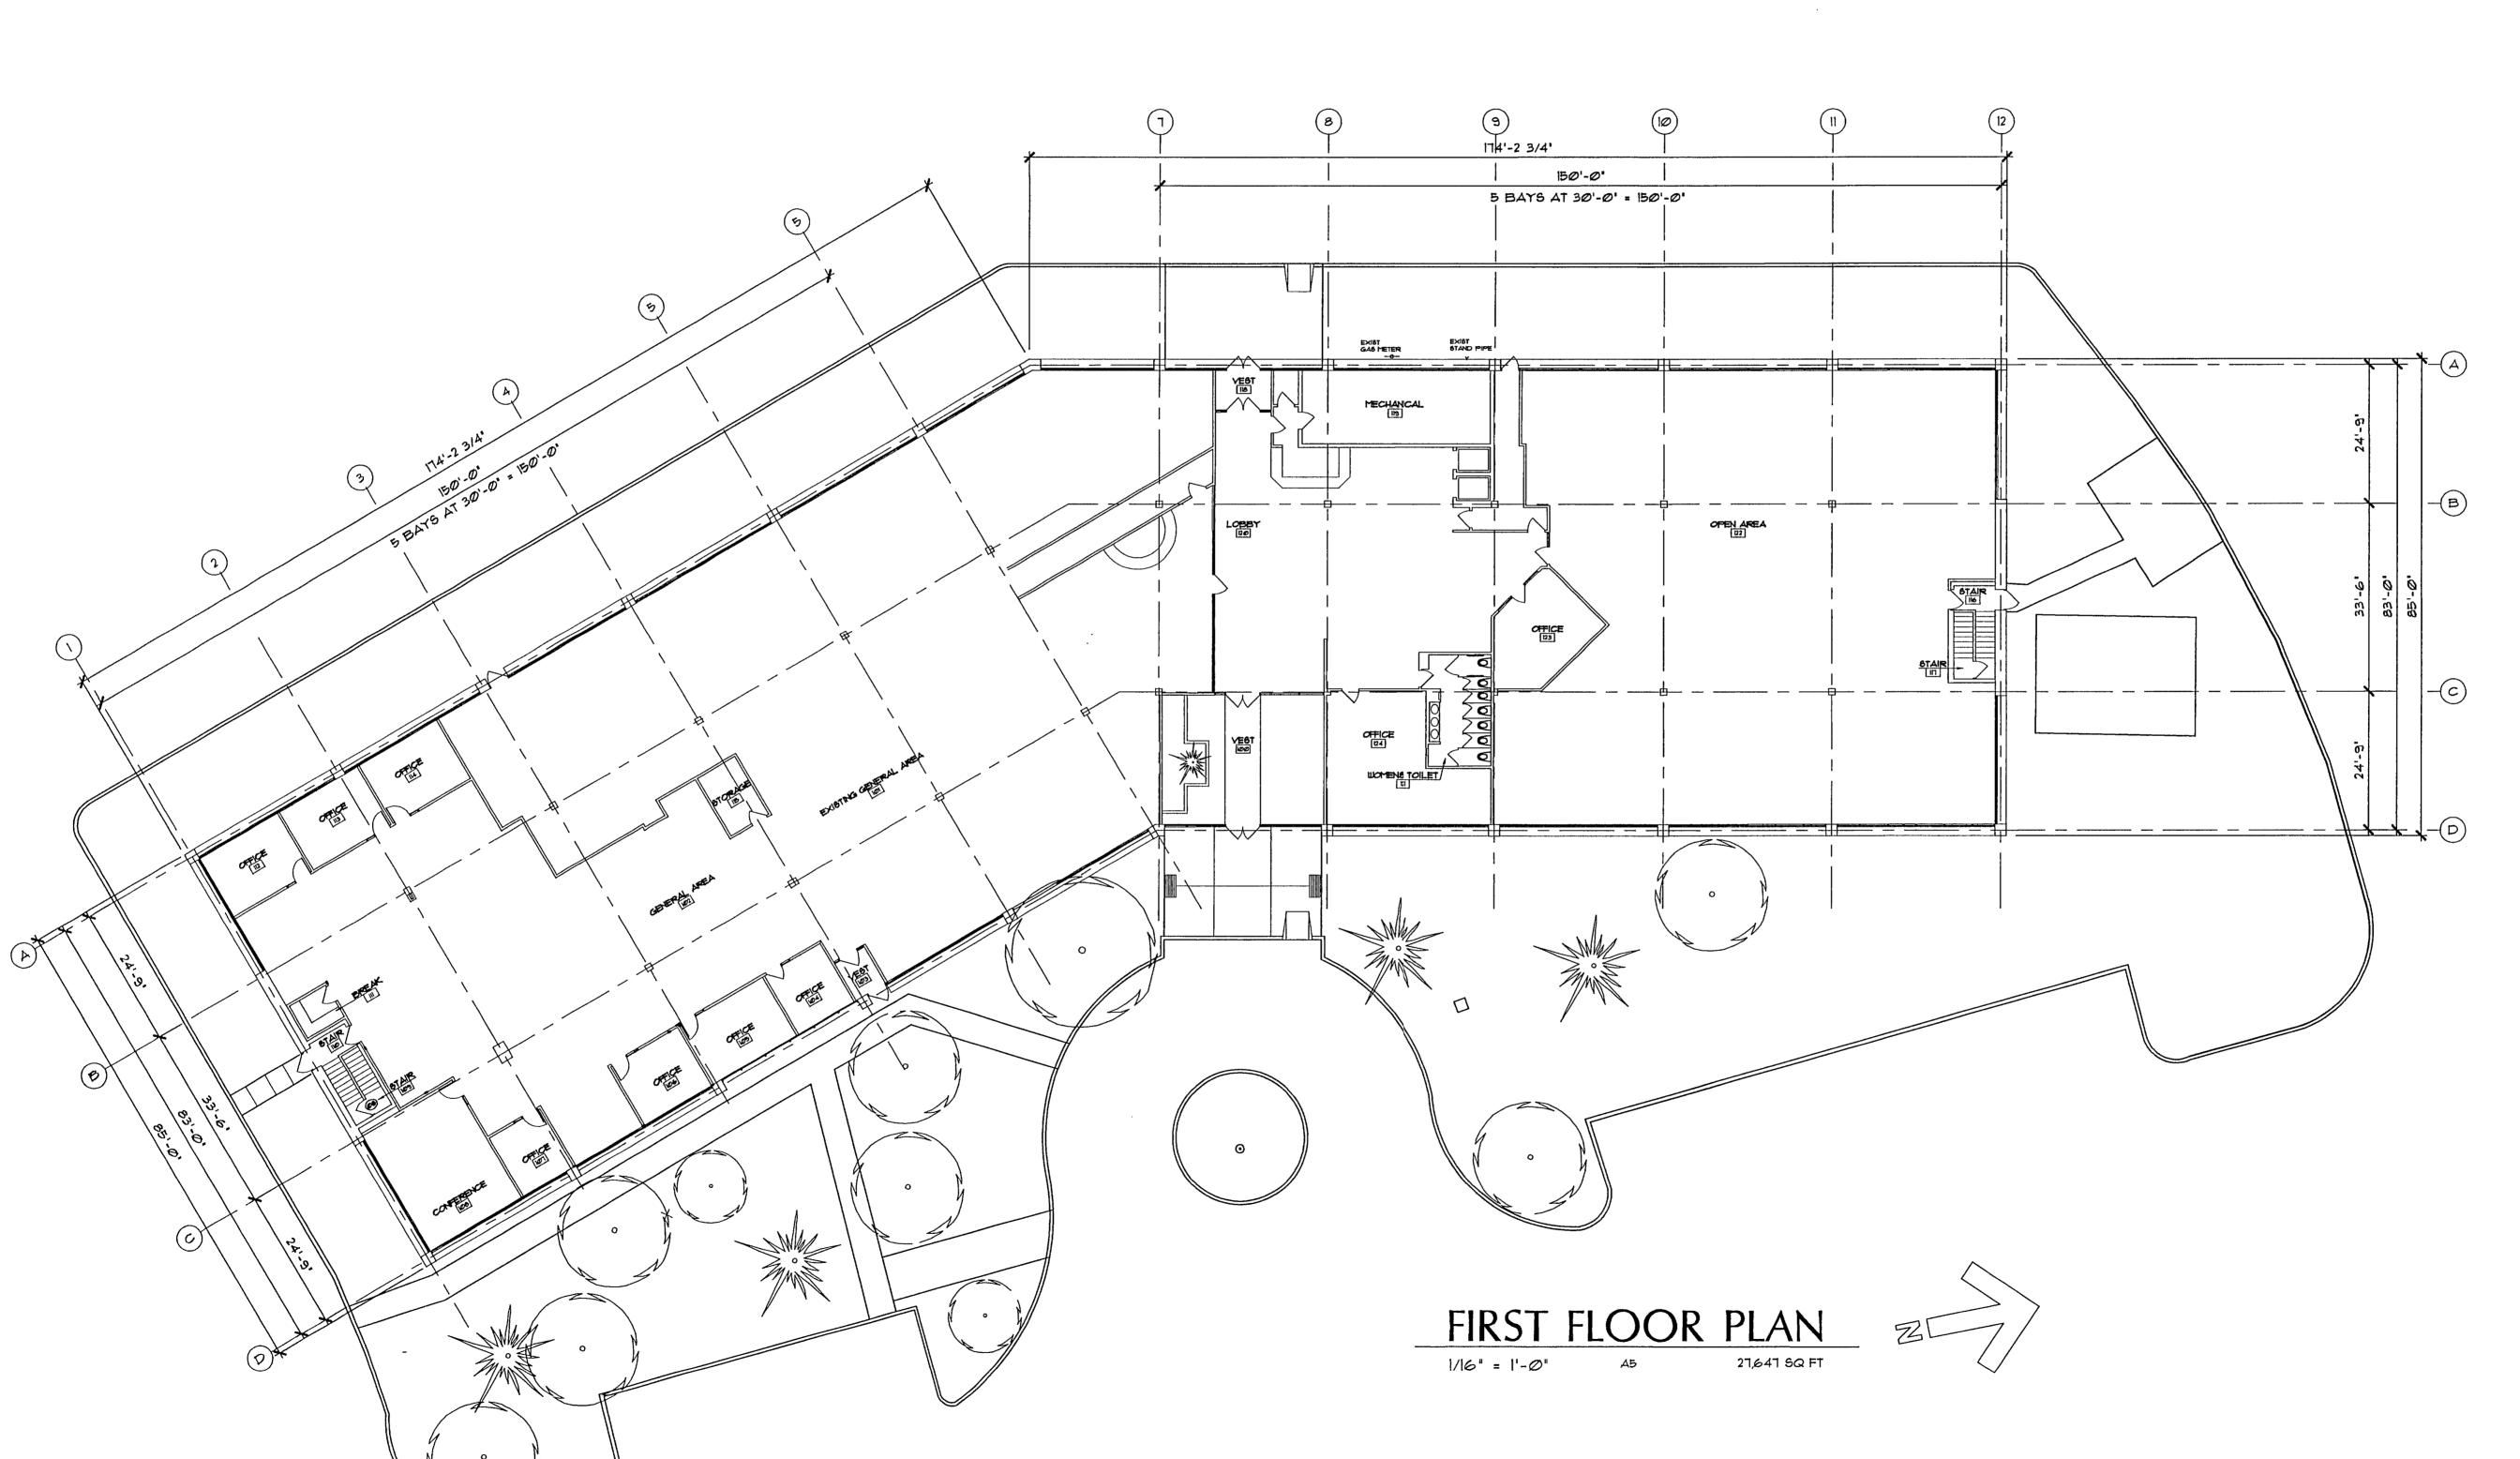


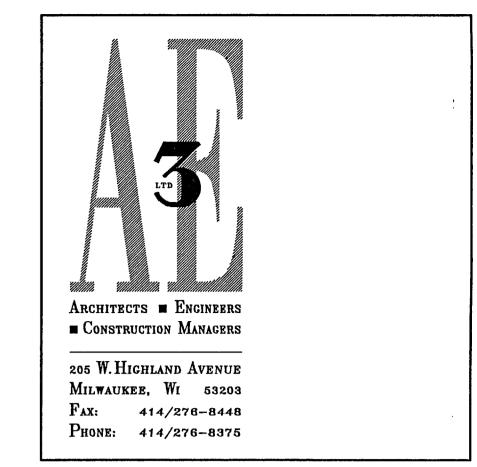


P	ROJE	ECT		
	4000	GUARANT W BROWN WN DEER, V	DEER ROA	
P	ROJE	CT TYP	E	
L	EGEN	NDS		
		•		1
				}
R	FVIS	IONS		
NO.	DATE	DESCRIPTION		CONST
		OOR PLAN	ENTS	· · ·
	AISC.	INFO	SHEET	•
	TE:	11/13/98		
	OJECT NO.	98047	A •	

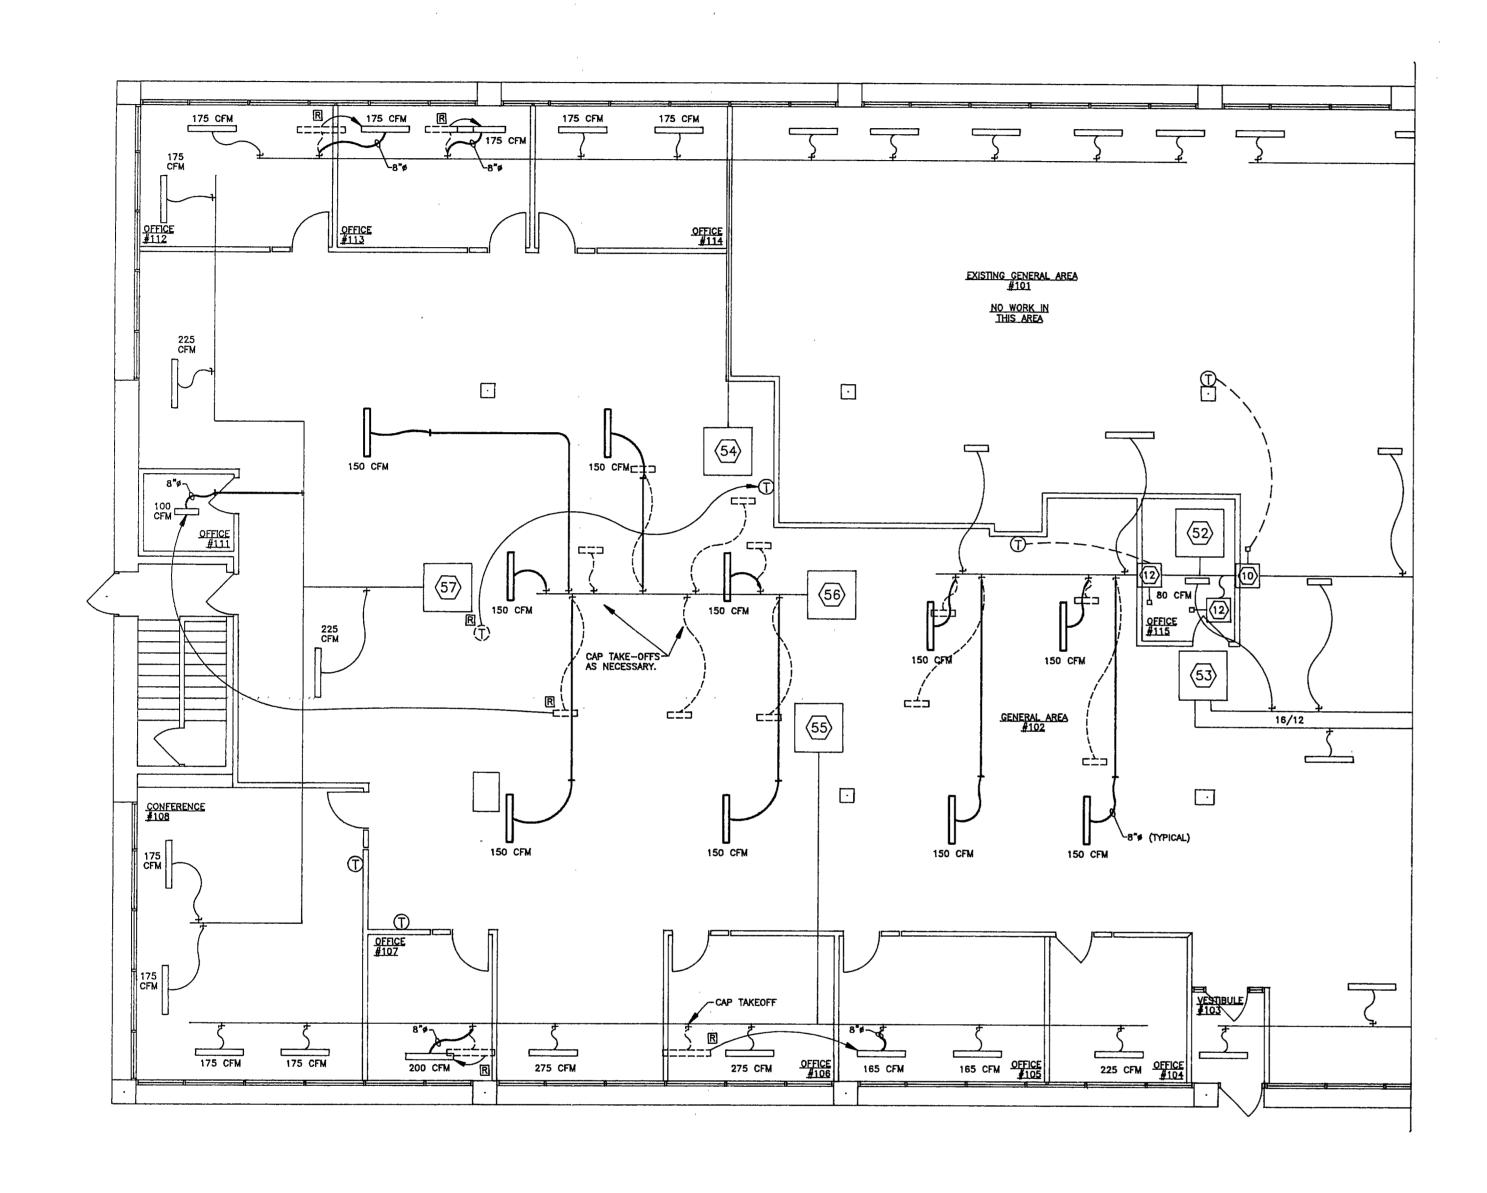

the second of the second

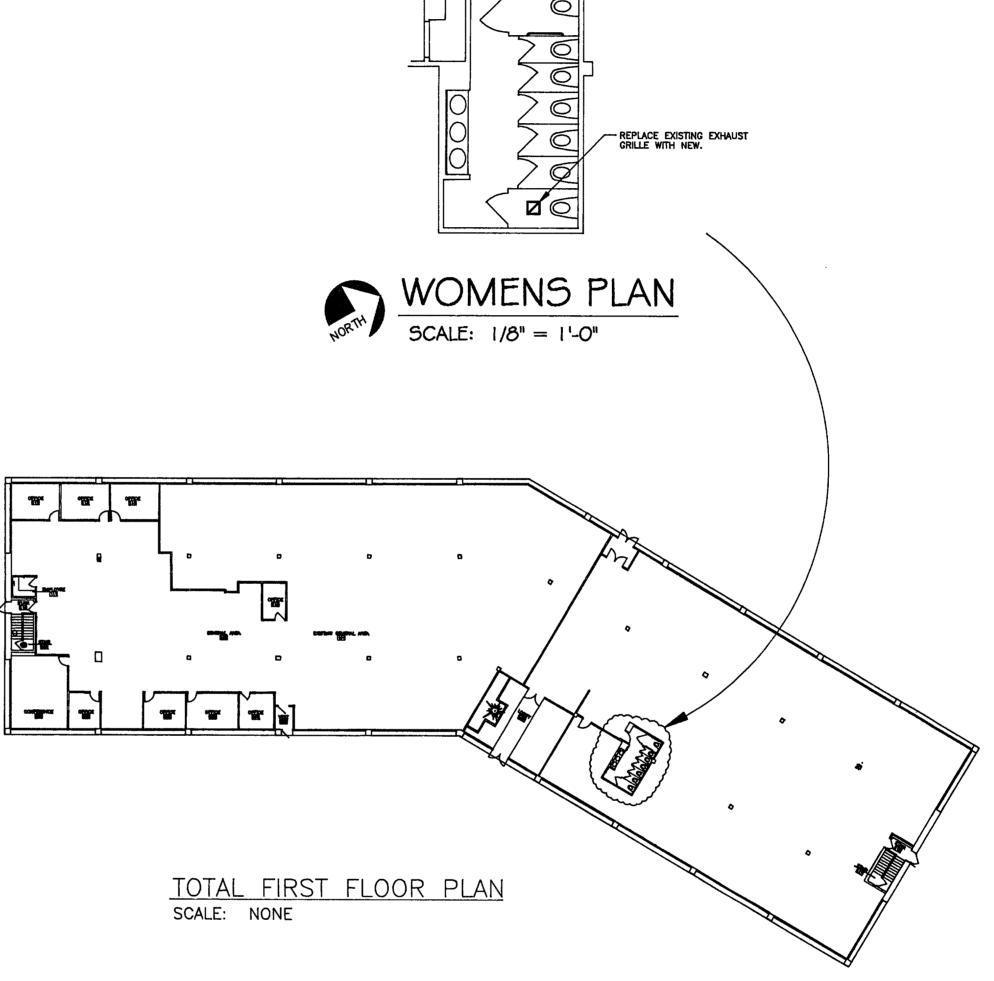

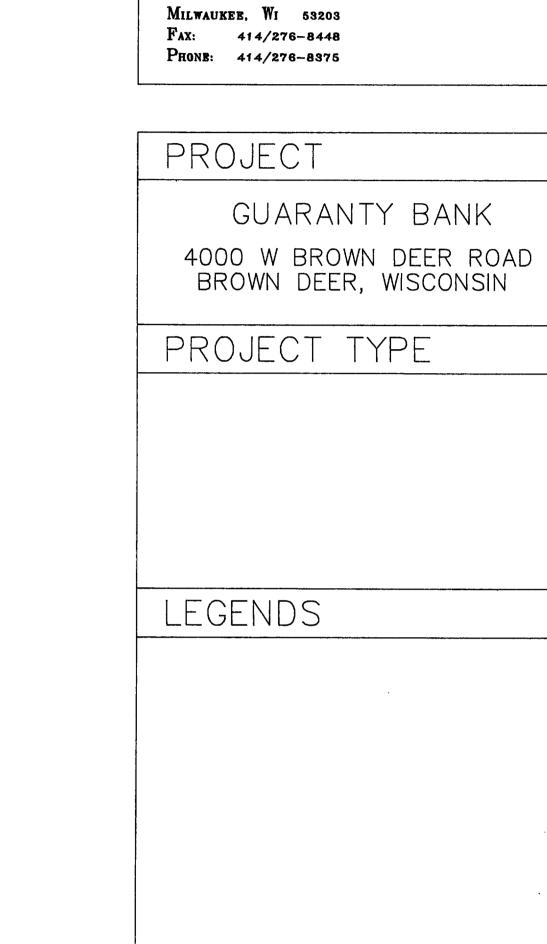


ARCHITECTS E ENGINEERS ■ Construction Managers


205 W. HIGHLAND AVENUE




PARTIAL FIRST FLOOR HVAC PLAN

SCALE: 1/8" = 1'-0"

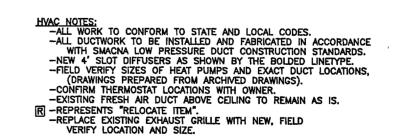

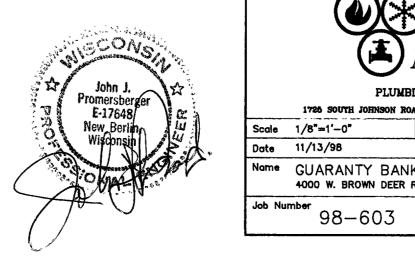

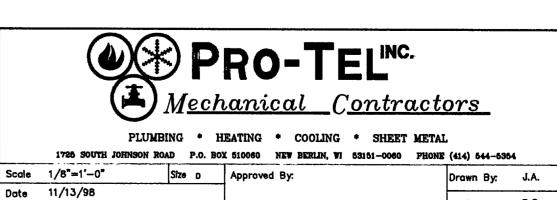

Name GUARANTY BANK
4000 W. BROWN DEER ROAD, BROWN DEER, WI


L	I DAI
(414) 544-6364	PRO
Drawn By: J.A.	
Designed By: B.S.	
Checked By:	7
Drawing Number HVAC 1 OF 1	


SHEET CONTENTS FLOOR PLAN SHEET 10/28/98 OJECT NO.

CONST

REVISIONS

NO. DATE DESCRIPTION

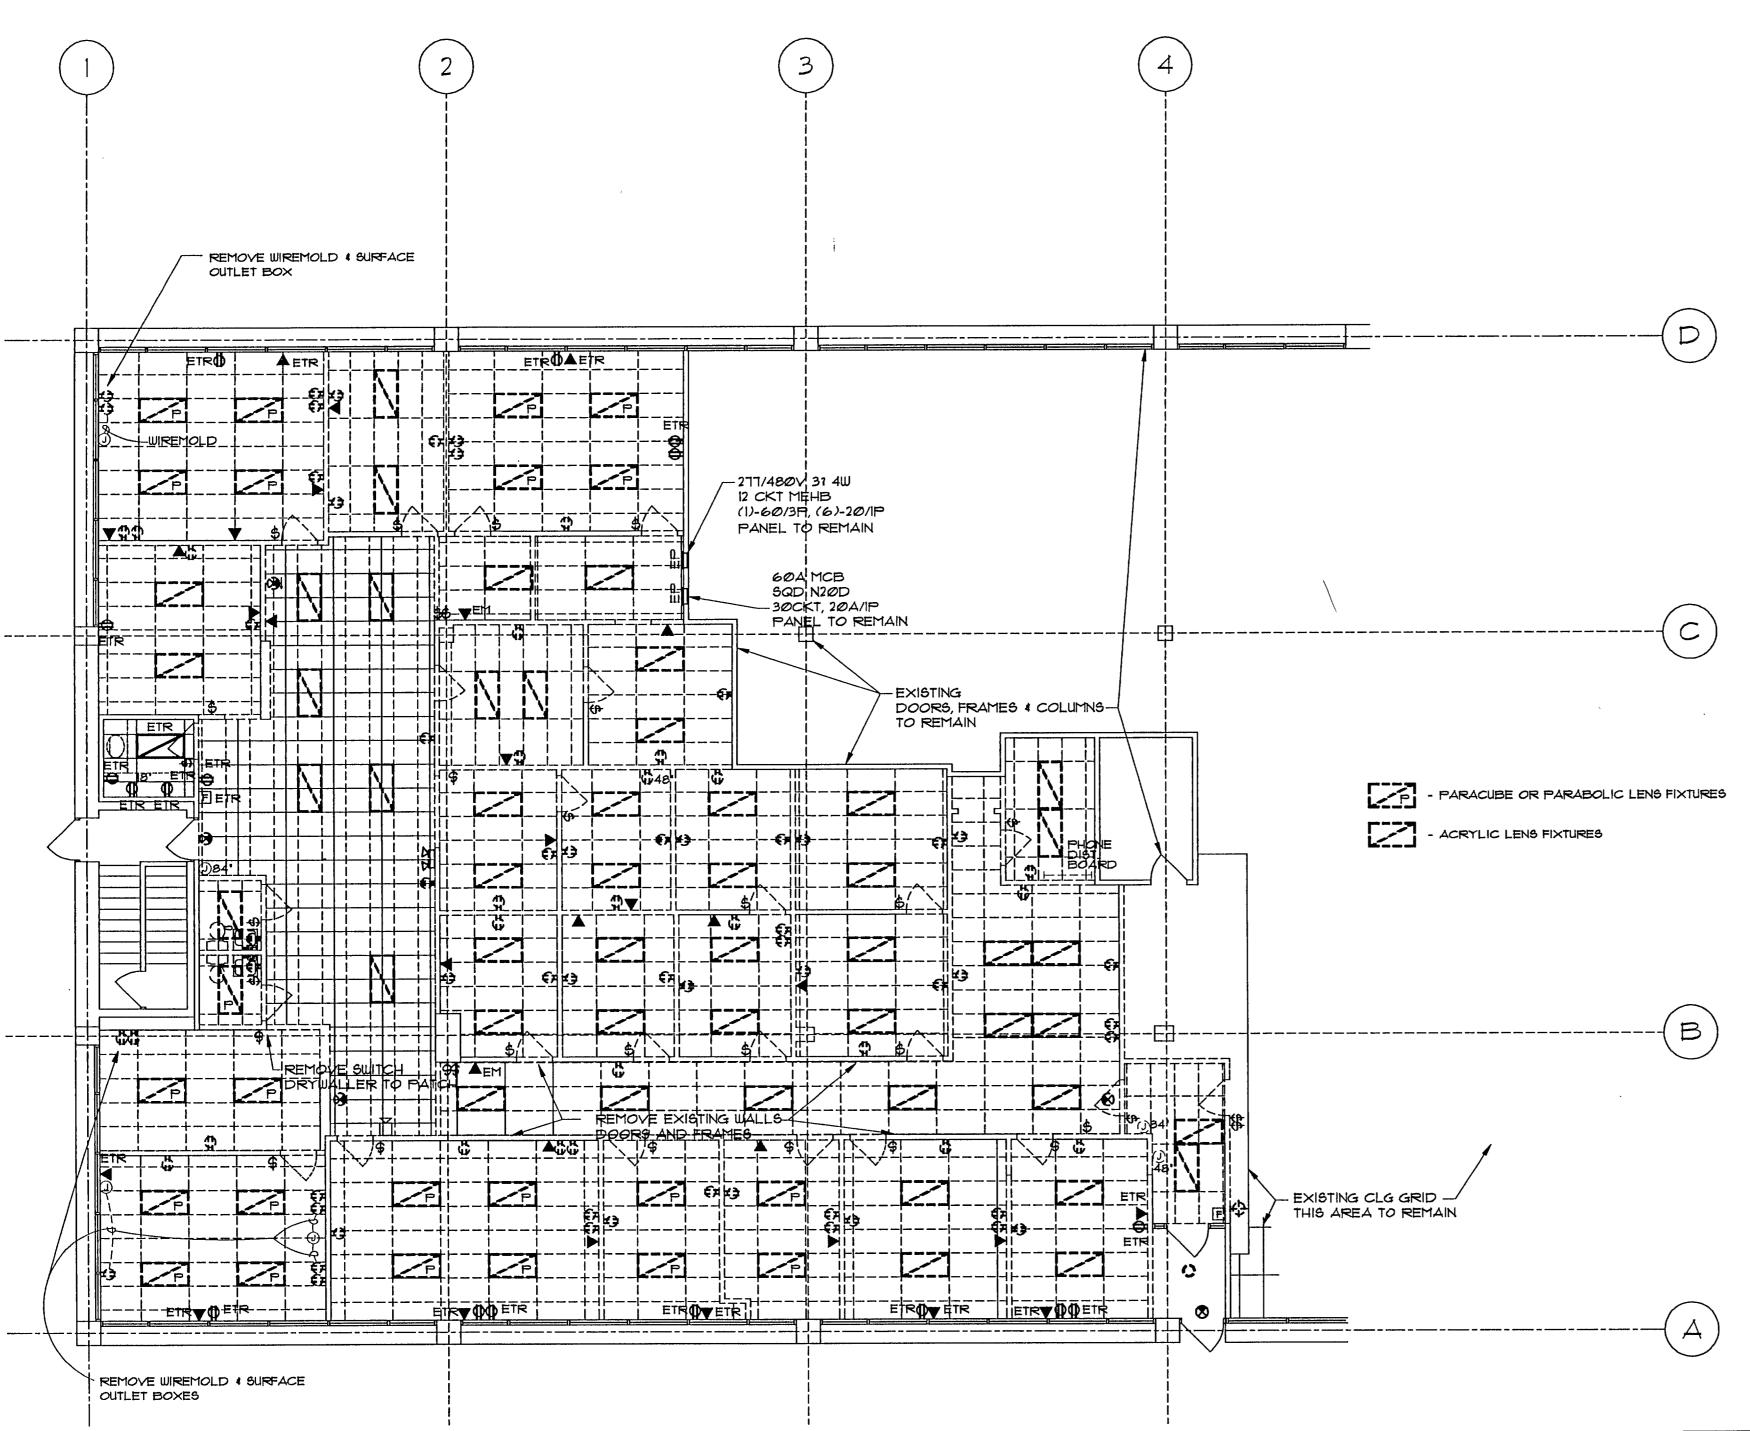

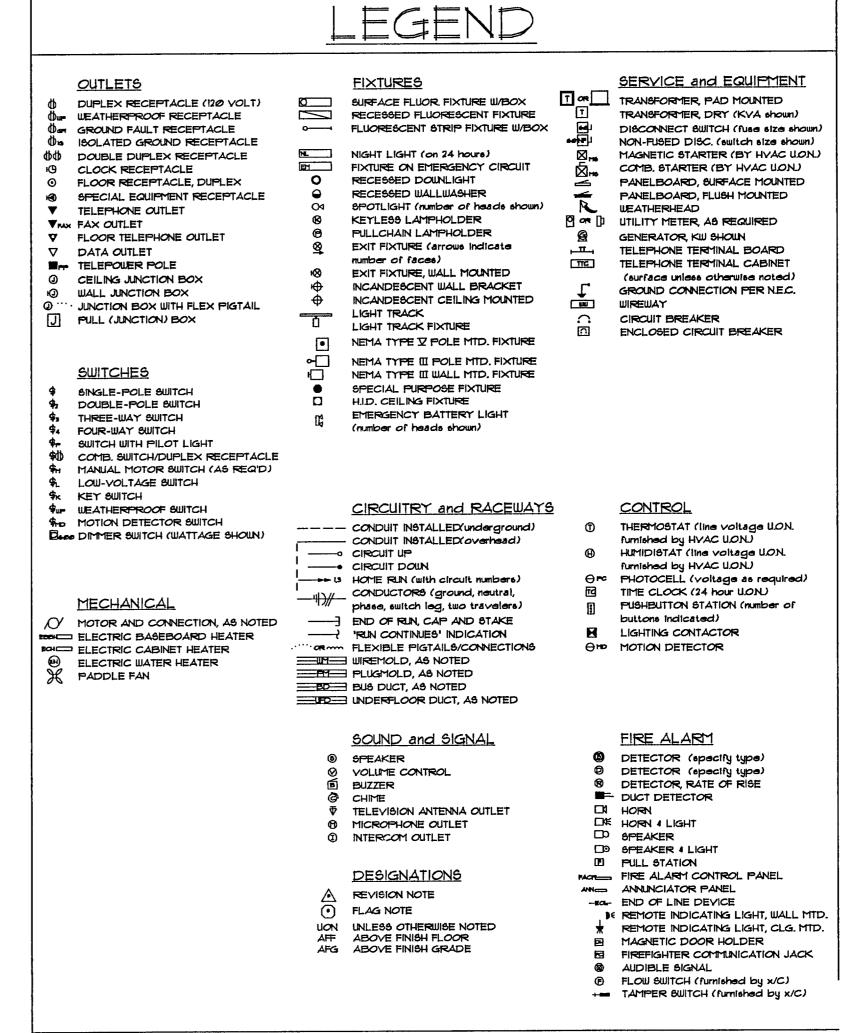



Architects - Engineers ■ Construction Managers

205 W. HIGHLAND AVENUE MILWAUKEE, WI 53203 FAX: 414/276-8448 PHONE: 414/276-8375

P	RO	JEC	T

**GUARANTY BANK** 

4000 W BROWN DEER ROAD BROWN DEER, WISCONSIN

PROJECT TYPE

**LEGENDS** 

**REVISIONS** 

NO.	DATE	DESCRIPTION	CONST
	<u> </u>		
			,
C	LIEET	CONTENTS	

SHEET CONTENTS

EXISTING/DEMO FLOOR PLAN

MISC. INFO

98047

11/13/98 PROJECT NO.


GENERAL NOTES:

PROVIDE BILL OF LADING SHOWING PROPER DISPOSAL OF FLUORESCENT LAMPS

AND BALASTS TO OWNER. EC SHALL DISCONNECT WIRING TO WALLS BEING DEMOLISHED FOR DISPOSAL BY DEMOLITION CONTRACTOR.

1/8" = 1'-0"

EXISTING ELECTRICAL DEMO FLOOR PLAN

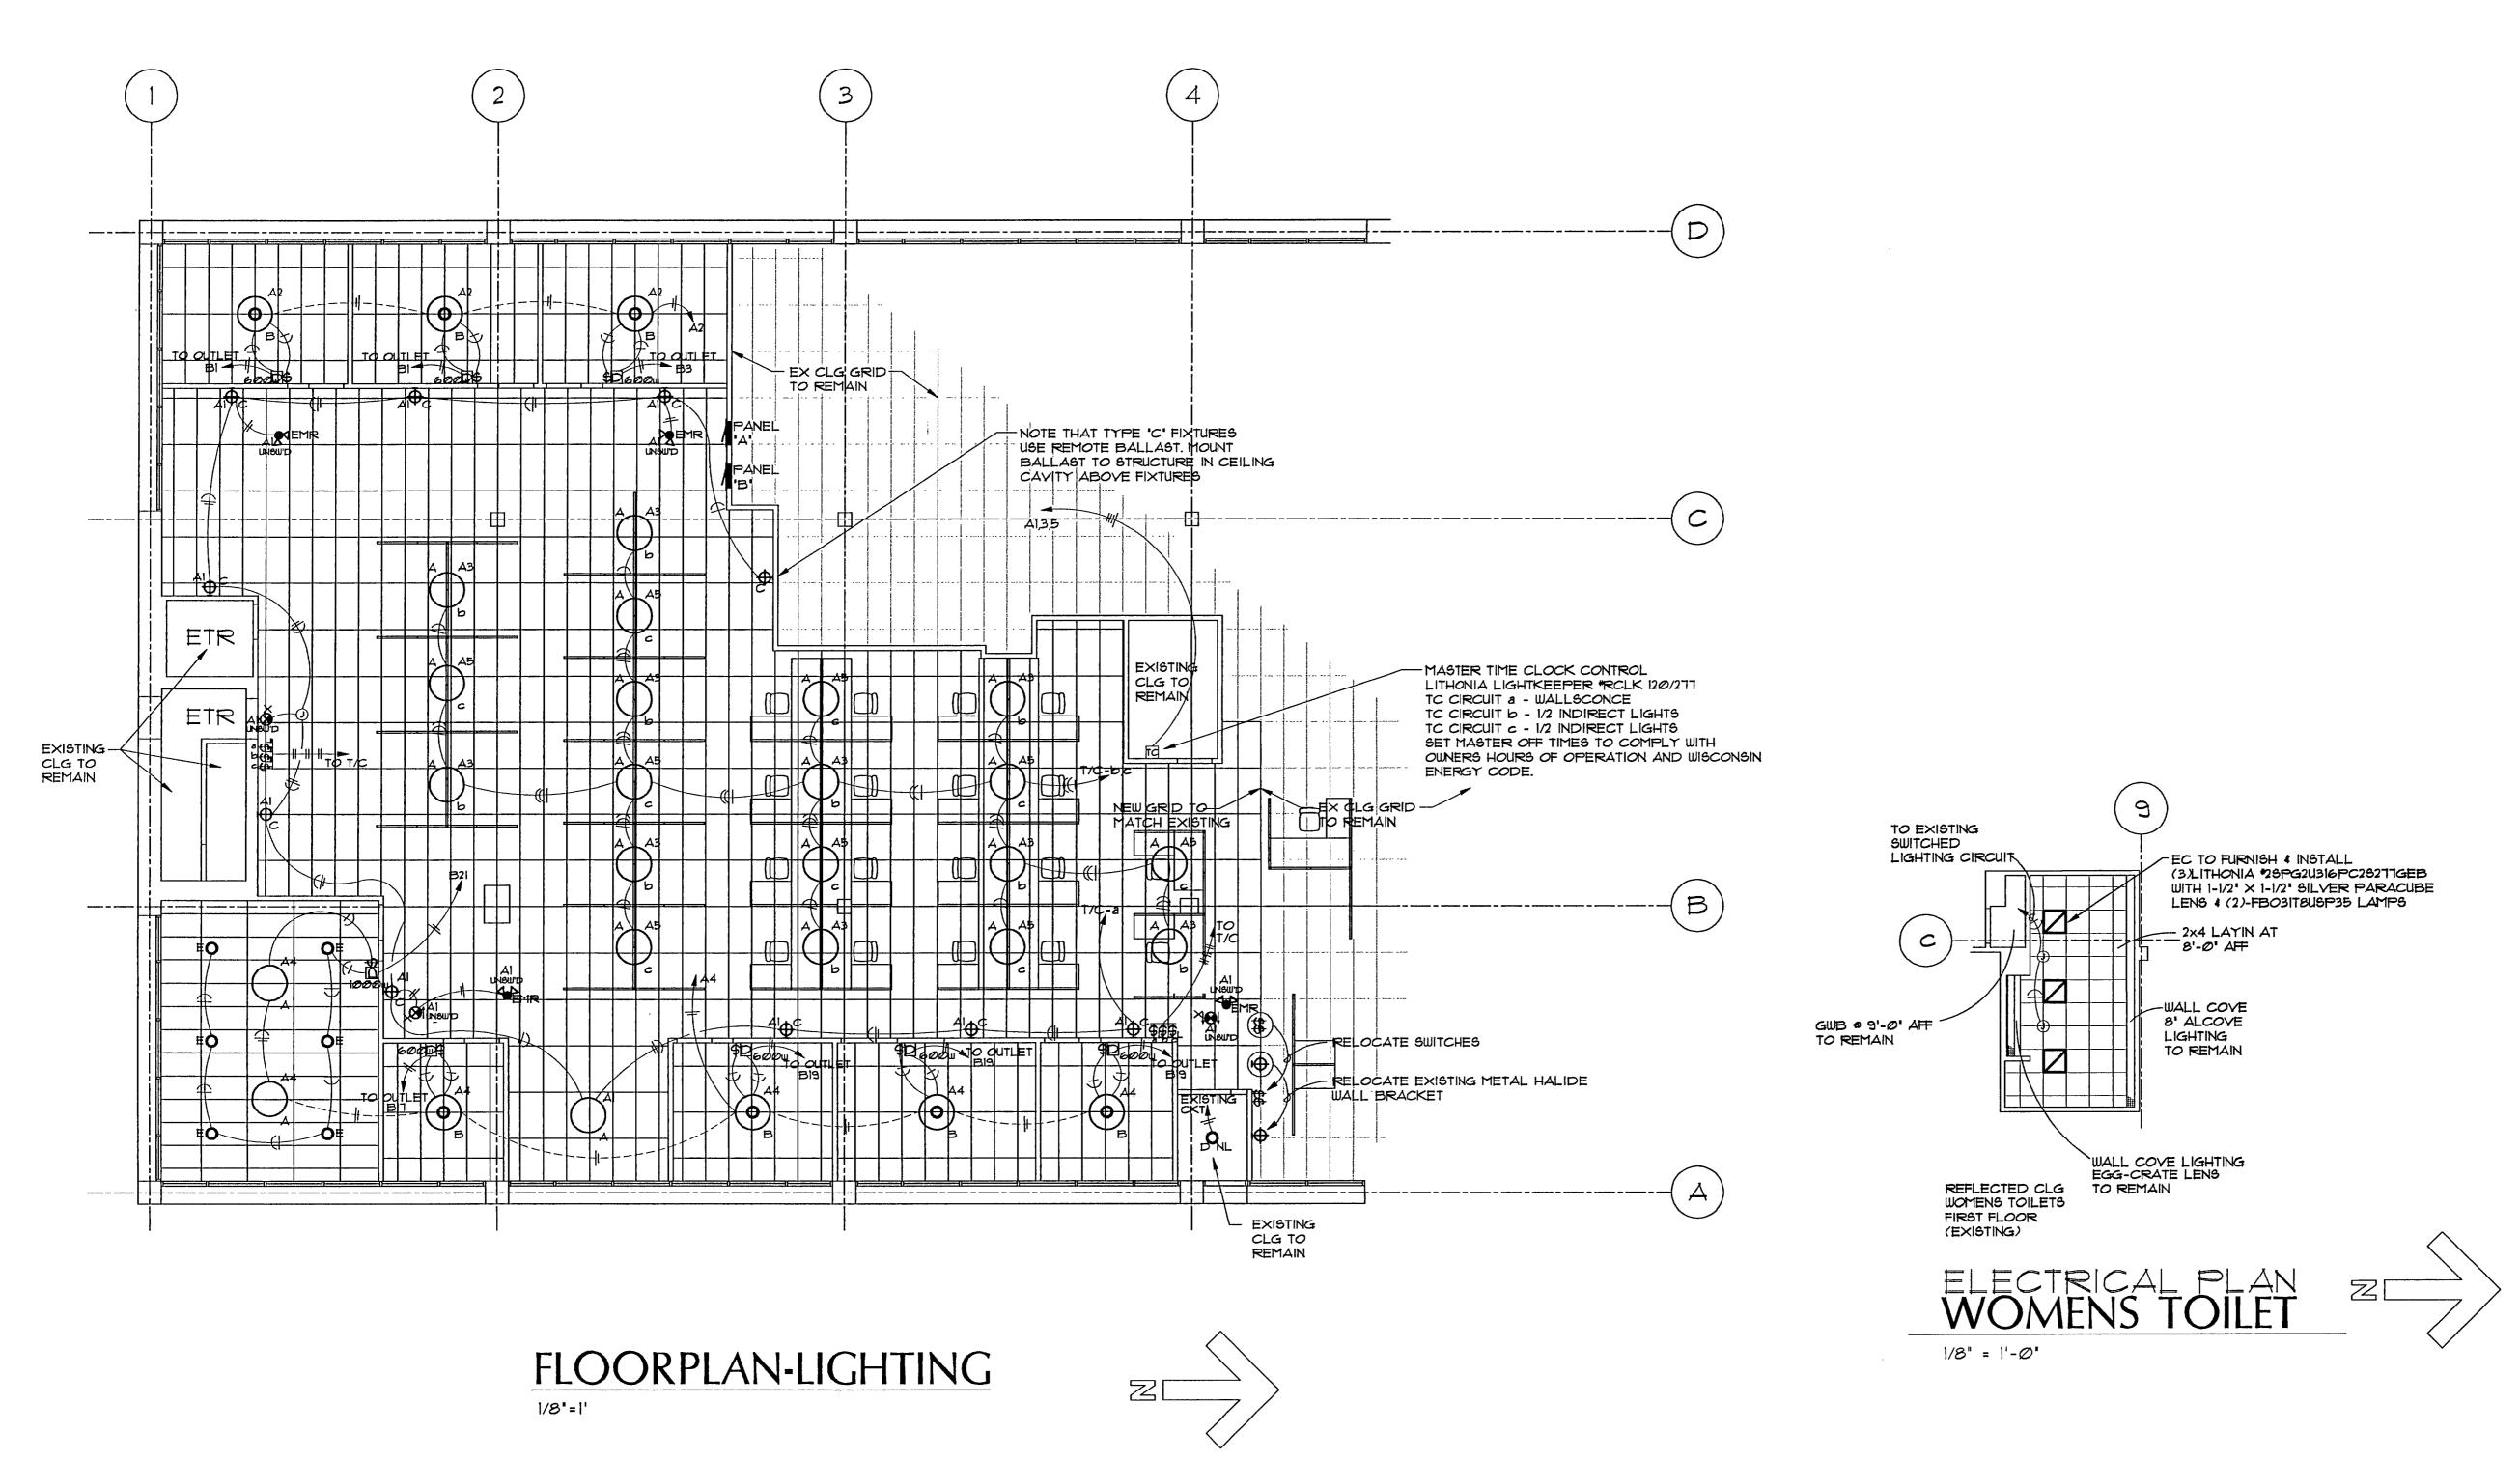

BUSSING AMPS: 100 VOLTAGE277/480 PHASE:3 WIRE:4 NEMA:1 SCHEDULE FOR PANELA MOUNTING: FLUSH REMARKS EXISTING PANEL TYPE:NEHB

OFFICE LIGHTING - WEST

INDIRECT LIGHTING (1/2 LEVEL) | 12 | 1 | 20 | 5 | 2800 | --- C | 600 | 6 | 20 | 1 | 12 EXISTING CIRCUIT 12 12 12 1 5000 A--- 0 8 nn n nn SPACE SPACE 6 3 60 9 5000 -B- 0 10 nn n nn TRANSFORMER SPACE 把 腔 腔 11 50000 ——C の 12 nn n nn TOTAL CONNECTED VA25920 PHASE B: 9200 PHASE C: 8400 (CONTINUOUS VA ( 10320 x 100 : 10820 + (REMAINDER x 060) = TOTAL DEMAND VAI9680 TL AMPS: 23.71

WIRE PAMP CCT V/A PHASE V/A CCT AMP P WIRE

INDIRECT LIGHTING (1/2 LEVEL) | 12 | 1 20 | 3 | 2520 -B- | 1680 | 4 | 20 | 1 | 12 | OFFICE/CONFERENCE LTG. - EAST

WALL SCONCE & EMERG. LTG | 12 | 1 20 | 2480 | A---- | 840 | 2 | 20 | 1 | 12

MAINS: 100A MLO

		P DATA		LIGHTING	FIXTURE	44011117110	CEILING	SEE	
TYPE	NO.	TYPE	DESCRIPTION	MAKE	CATALOG NO.	MOUNTING	TYPE	NOTE	VOLT
Α	3	39FLTT	INDIRECT FLUORESCENT PENDANT	SPI	OPW2891-277WH	AIRCRAFT	GRID		277
	3	50FLTT	WITH WHITE FINISH			CABLE PENDANT			
В	3	39FLTT	INDIRECT FLUORESCENT PENDANT	SPI	OPW2891-277WH-DL	AIRCRAFT	GRID		277
	3	50FLTT	WITH INCANDESCENT DOWNLIGHT			CABLE PENDANT			
	1	55PAR16	& WHITE FINISH						120
С	мн	WITH UNIT	WALL MOUNTED METAL HALIDE	SPI	WALL	WALL		1	277
			QUARTER SPHERE WITH WHITE FINISH						
D	1	F32TTT	RECESSED FLUORESCENT DOWNLIGHT	RUUD OR EQUAL	R7F32-1	RECESSED	GRID		120
			WITH SILVER ALZAK REFLECTOR						
E	1	150A	RECESSED INCANDESCENT DOWNLIGHT	RUUD OR EQUAL	R7-RT19-CL	RECESSED	GRID		277
			WITH SILVER ALZAK REFLECTOR						
								<u> </u>	
Х	LED	WITH UNIT	UNIVERSAL MOUNT LED EXIT LIGHT W/ BATTERY UNIT	LITHONIA	LQMSW3R-EL	SURFACE	GRID		277
EMR	2 W	ITH UNIT	RECESS EMERGENCY LIGHTING UNIT W/ 2 FLOOD LAMPS	DUAL LITE	EZ2R	RECESSED	GRID		277
OA	1	175MH	GROUND MOUNTED FLOOD LIGHT WITH WHITE FINISH	LSI	DRSVF175MHFMTWHTNO	STAKE		2	120
OB	1	100MH	BOLLARD LIGHT WITH WHITE FINISH &	LSI	BVRDID100MHCPMTWHT	CONCRETE BASE		3	FIELD
		i	BLACK ACCENT BAND		NO55			1	VERIF

NOTES: 1.)PROVIDE WITH REMOTE MOUNTED 750 BALLAST 2.)PROVIDE STAKE MOUNTING PER DETAIL ON SHEET "E1" 3.)PROVIDE CONCRETE BASE PER DETAIL ON SHEET "E1"



ARCHITECTS ENGINEERS ■ Construction Managers

205 W. HIGHLAND AVENUE MILWAUKEE, WI 53203 FAX: 414/276-8448 PHONE: 414/276-8375

### **PROJECT**

**GUARANTY BANK** 4000 W BROWN DEER ROAD BROWN DEER, WISCONSIN

### PROJECT TYPE

1				<b>L</b> 1		_
1	<b> -</b> -	ſ.	. 1		1	
		V I		ľ		_

	LIGHTS SUPPLIED
( )	BY EC, INSTALLED
	BY EC

SUPPLY GRILLES
TO MATCH EXISTI

### **REVISIONS**


NO.	DATE	DESCRIPTION	CONST
-	,		

### SHEET CONTENTS

FLOOR PLAN — LIGHTING

MISC. INFO

11/13/98 PROJECT NO.

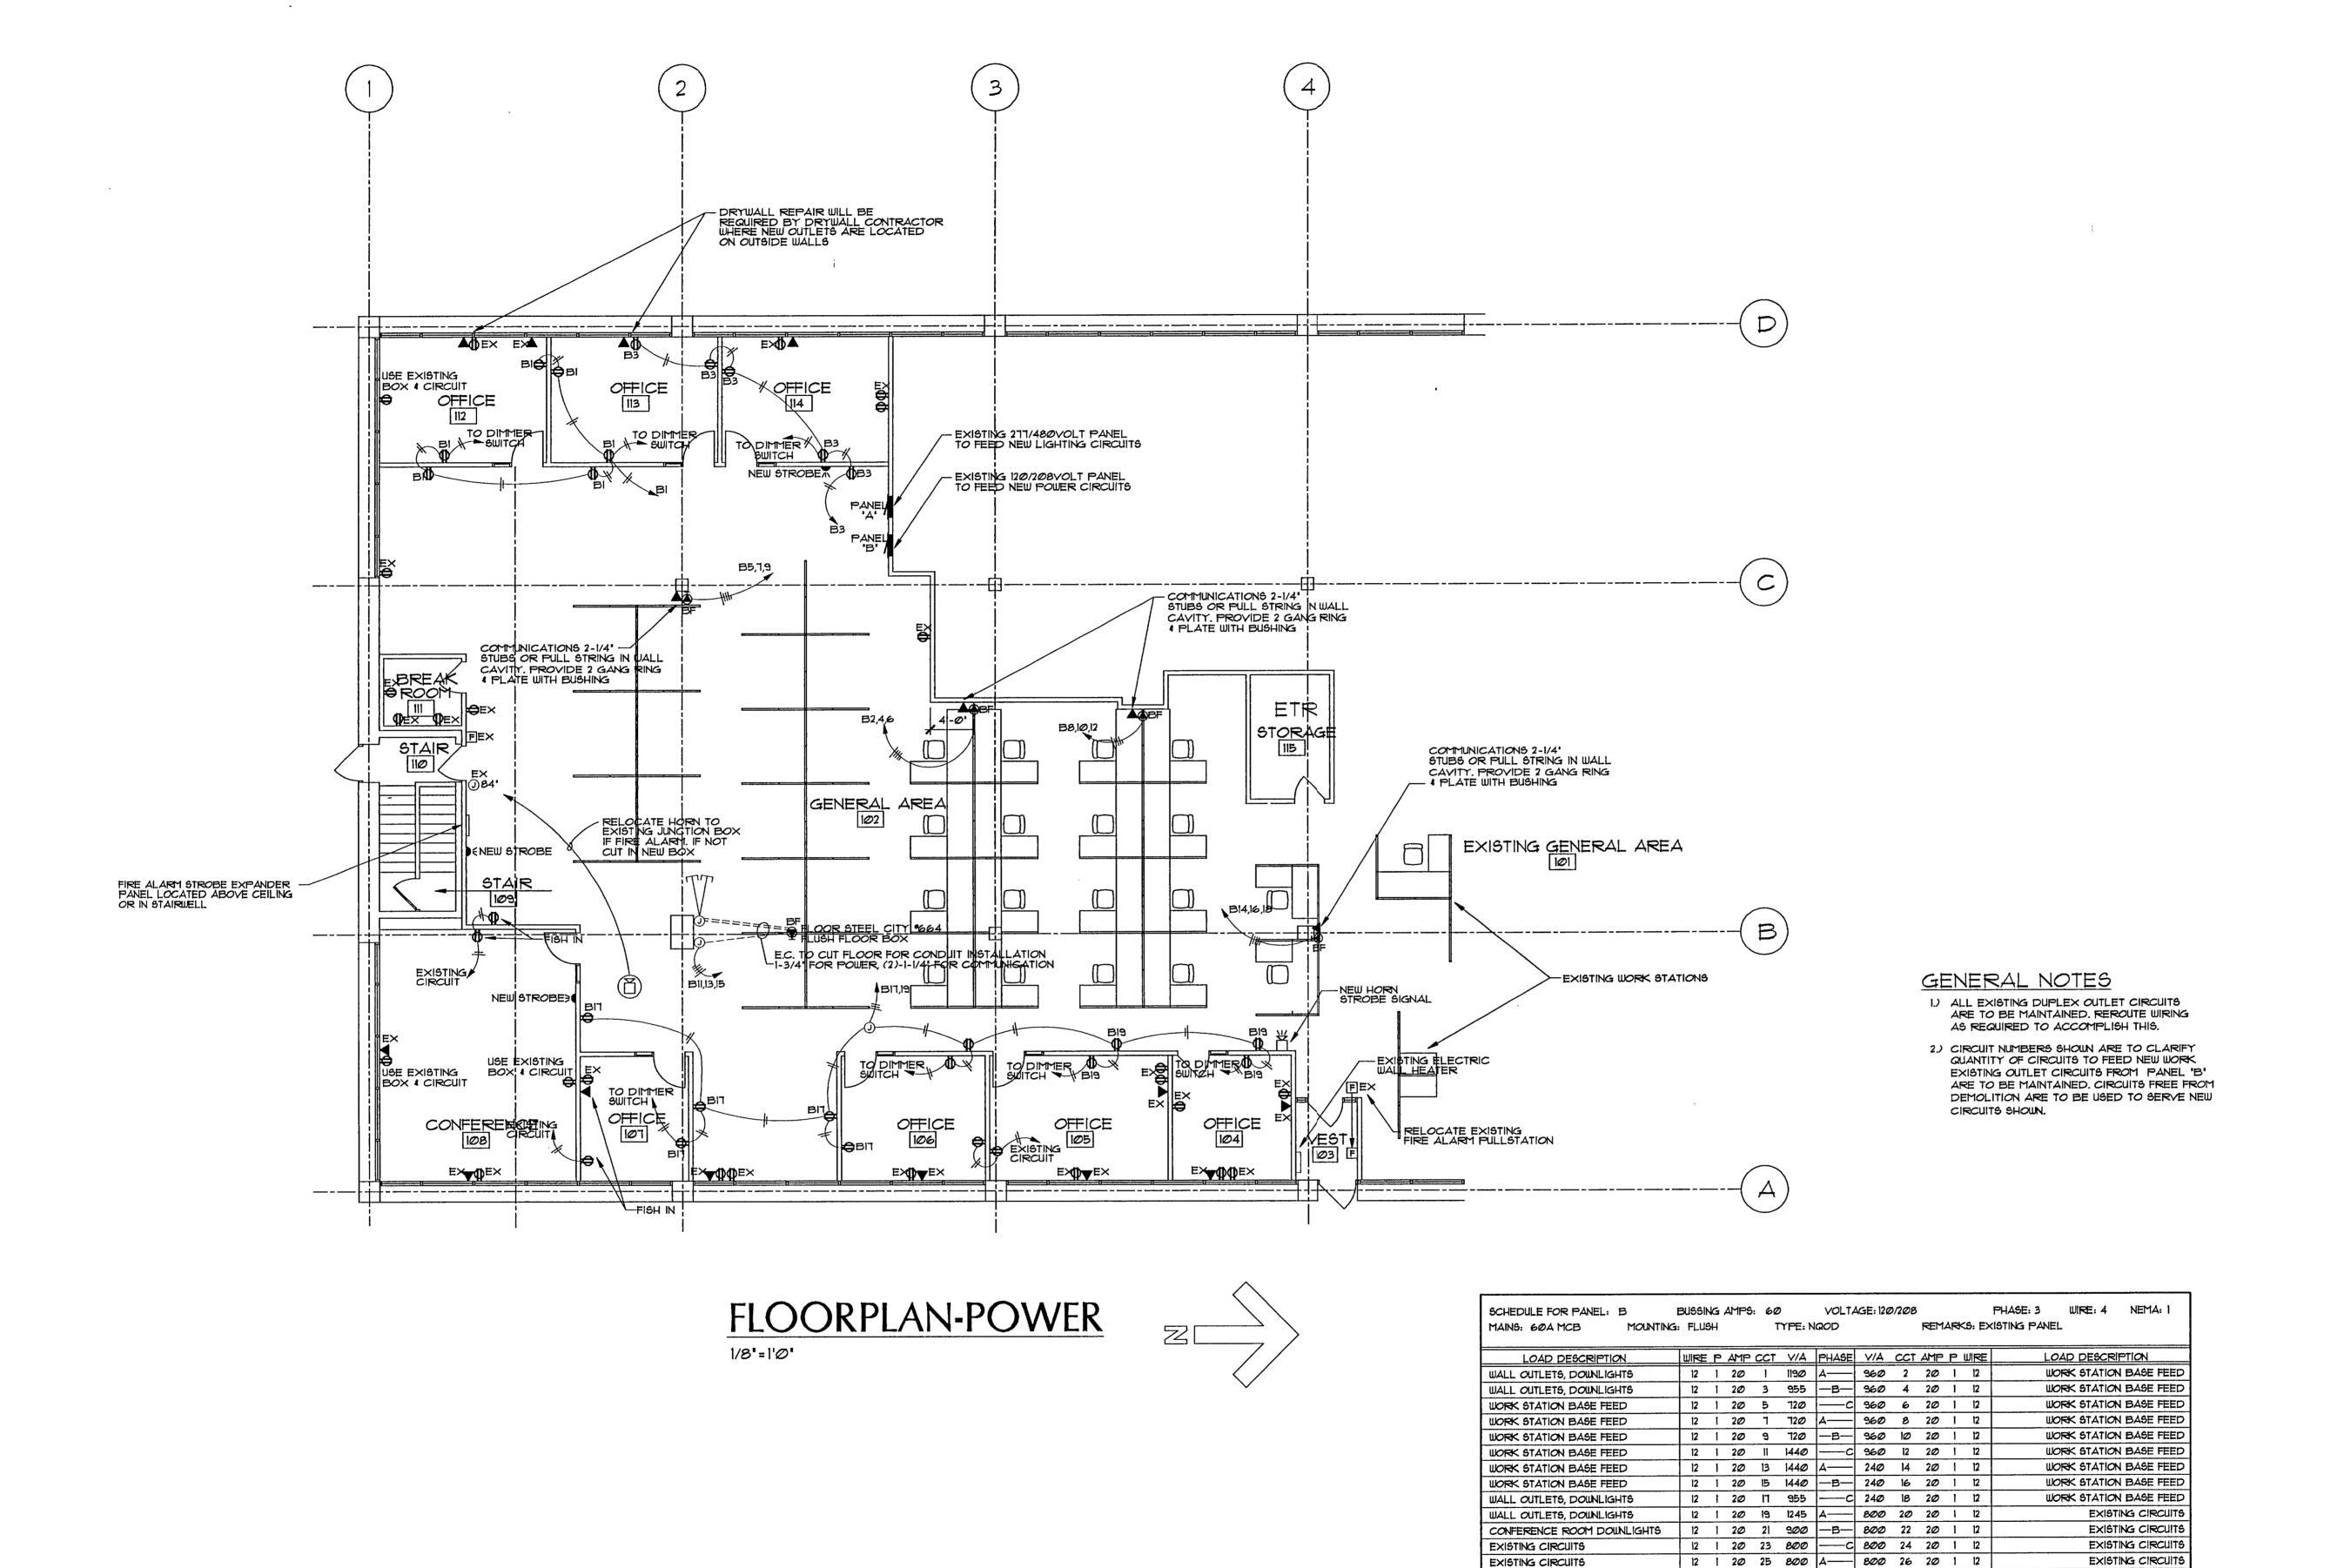

EXISTING CIRCUITS

EXISTING CIRCUITS

VOLTAMPS: PHASE A: 9155

(CONTINUOUS VA ( 385x 100 :

12 1 20 27 800 -B- 800 28 20 1 12


PHASE B: 8515 PHASE C: 8415 TOTAL

) 385 + (REMAINDER x 060) = TOTAL DEMAND VA: 15811


EXISTING CIRCUITS

TL AMPS: 44.10

TOTAL CONNECTED VA: 26205

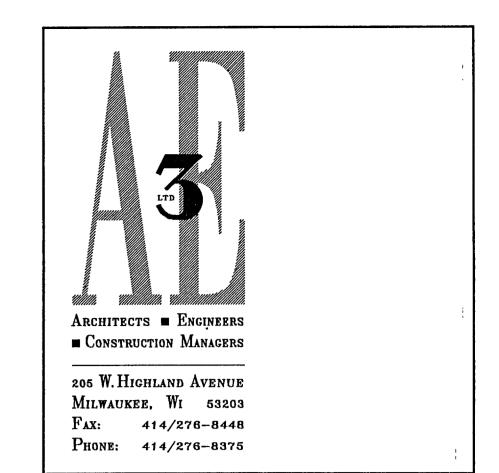

PROJECT	
GUARANTY BANK	
4000 W BROWN DEER RC Brown Deer, Wisconsi	
PROJECT TYPE	
LEGENDS	
REVISIONS	1
NO. DATE DESCRIPTION	CONST
SHEET CONTENTS	
FLOOR PLAN — ELECTRICAL POWE	ER
MISC. INFO SHEE	T
DATE: 11/13/98 PROJECT NO. 98047	3

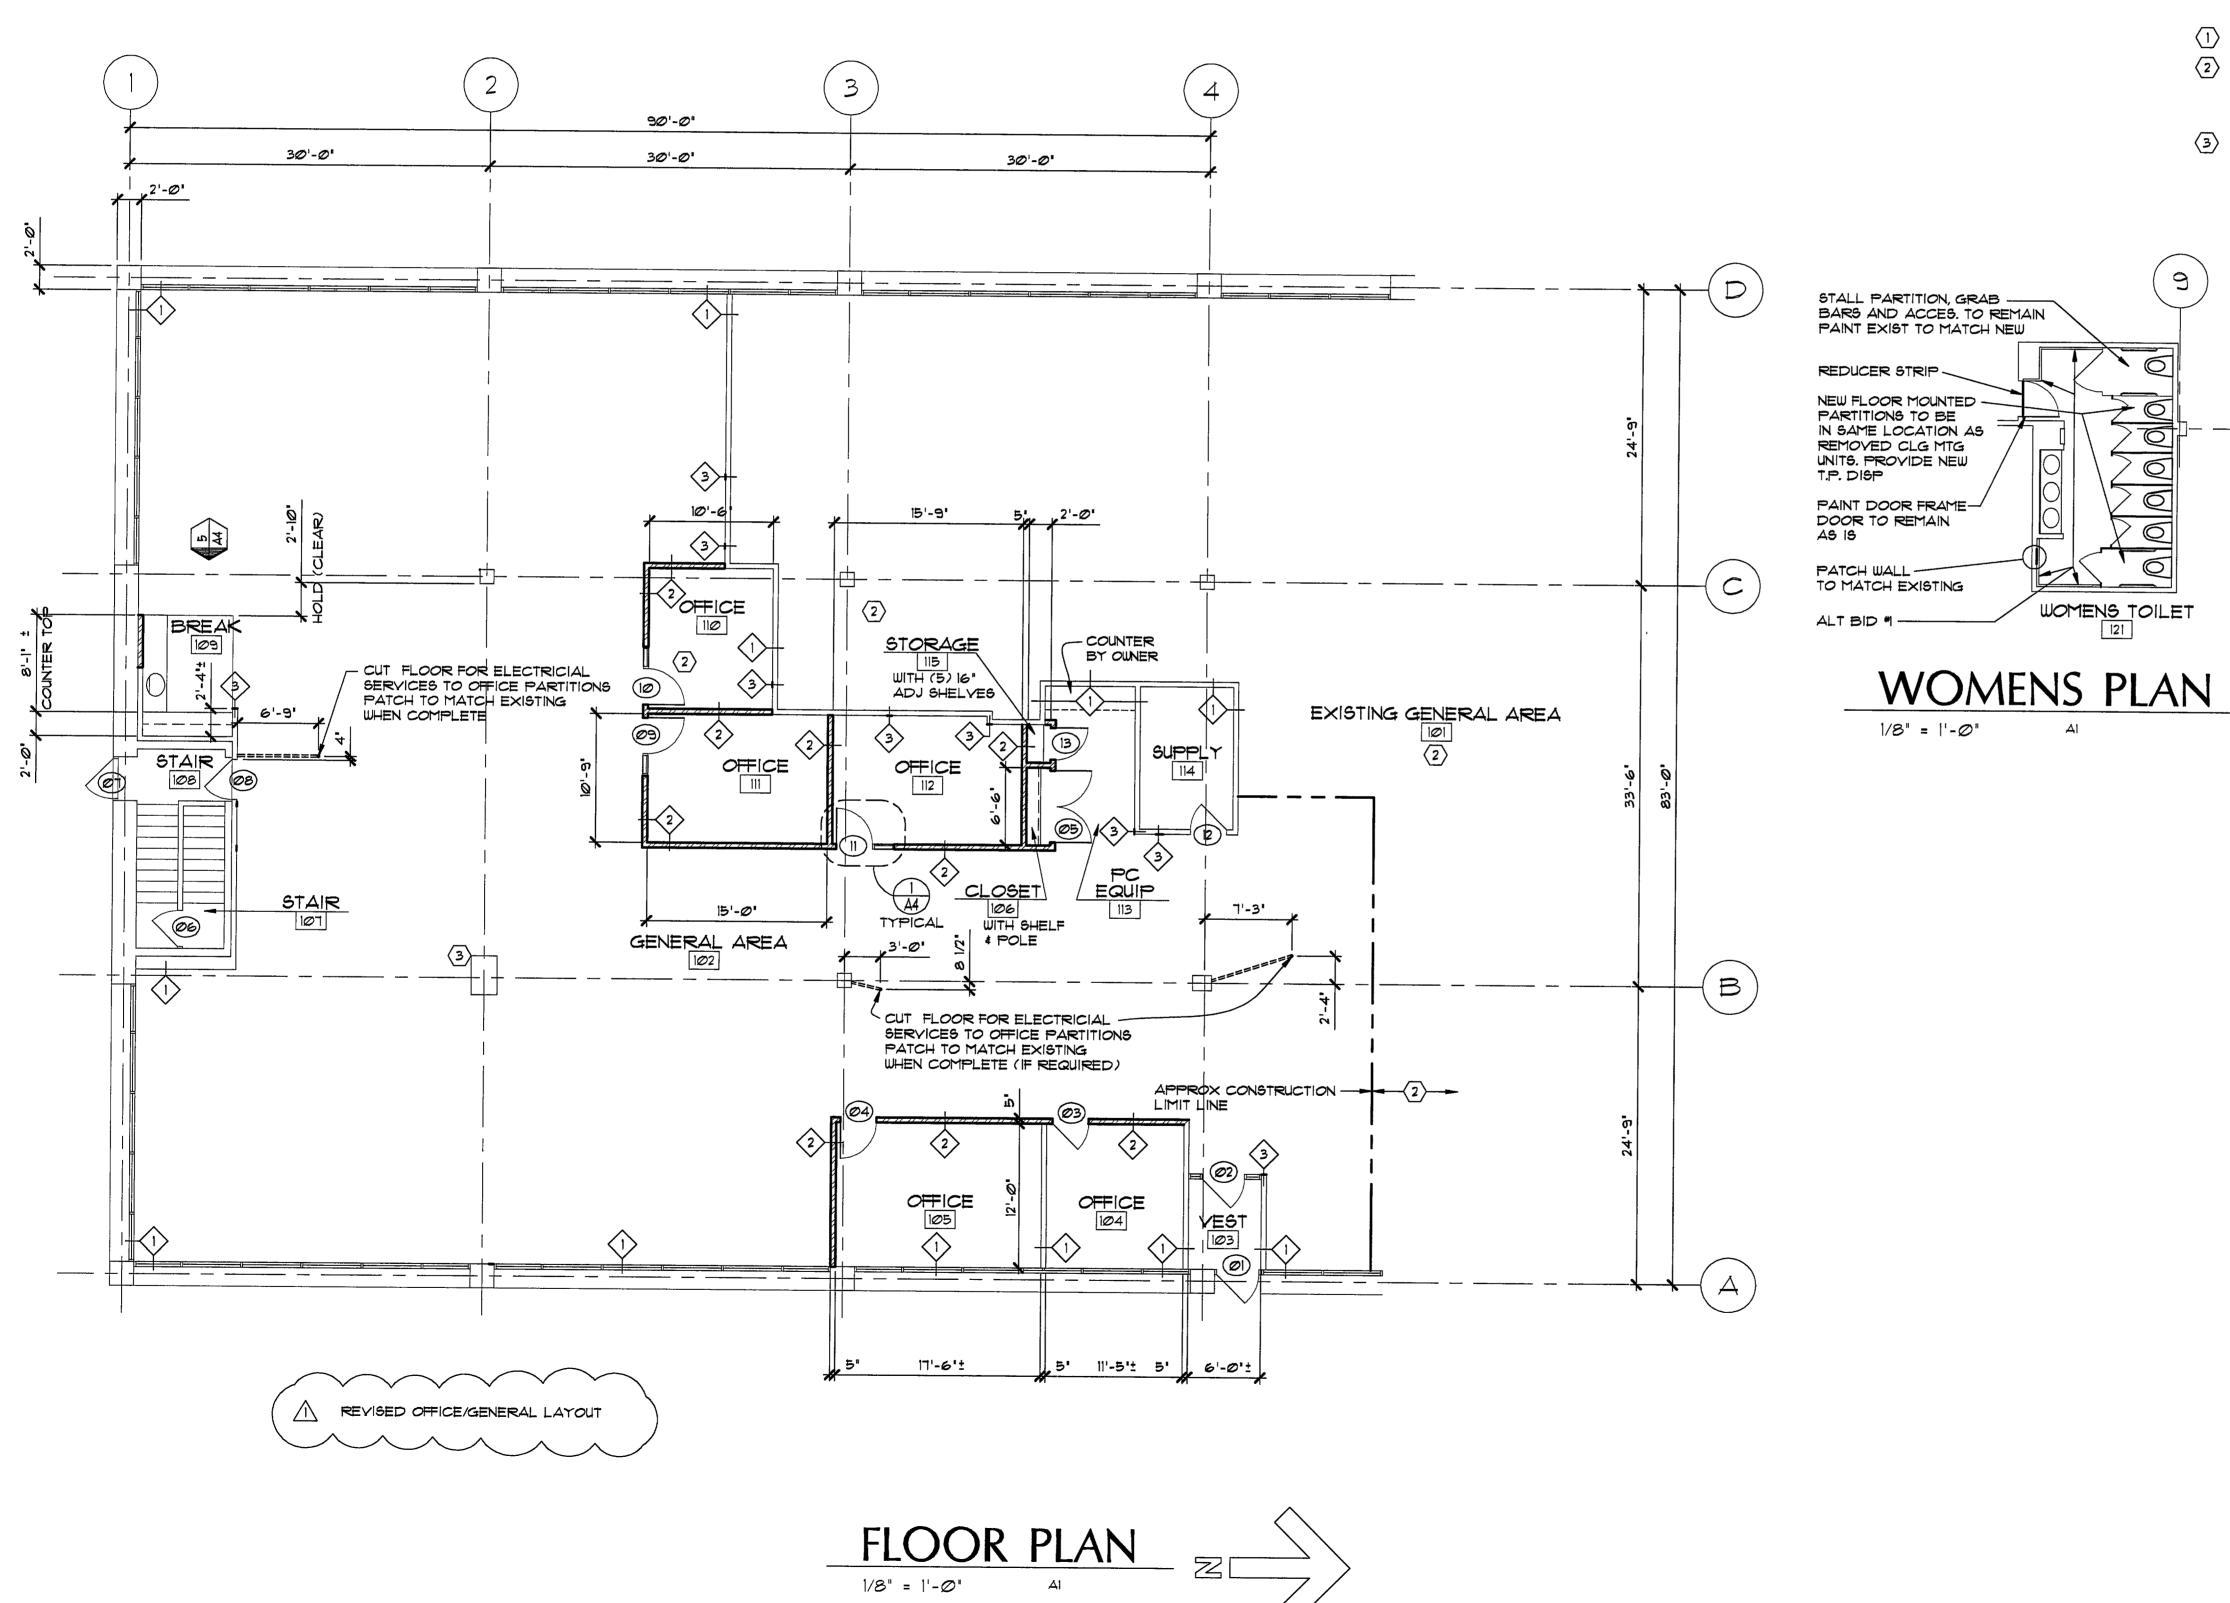

### WALL TYPES

 $\langle i \rangle$ 

EXISTING WALL TO REMAIN. PATCH AS REQUIRED SO APPEARANCE MATCHES NEW.

2

3 5/8" METAL STUDS AT 16" OC WITH 5/8"
GYPSUM WALLBOARD BOTH SIDES. STUDS
GO FLOOR TO STRUCTURE ABOVE. GWB
FROM FLOOR TO 4" MIN ABOVE CEILING.
PROVIDE 4" SOUND BLANKET FLOOR TO 4"
MINIMUM ABOVE CEILING.


3


PATCH EXISTING WALL AS REQUIRED WHERE ANOTHER EXISTING WALL WAS REMOVED. APPEARANCE TO MATCH NEW.

### **KEYED NOTES**

FI SEN N

- SEE SHEET A4 FOR DOOR & SIDELIGHT DETAILS
- THIS AREA NOT IN CONTRACT UNLESS
  NOTED OTHERWISE OR UNLESS REQUIRED
  DUE TO WORK IN CONTRACT AREA.
  (WOMENS TOILET ROOM IN CONTRACT)
- MAKE COLUMN 2B AS SMALL AS POSSIBLE. KEEP A RECTANGULAR SHAPE.

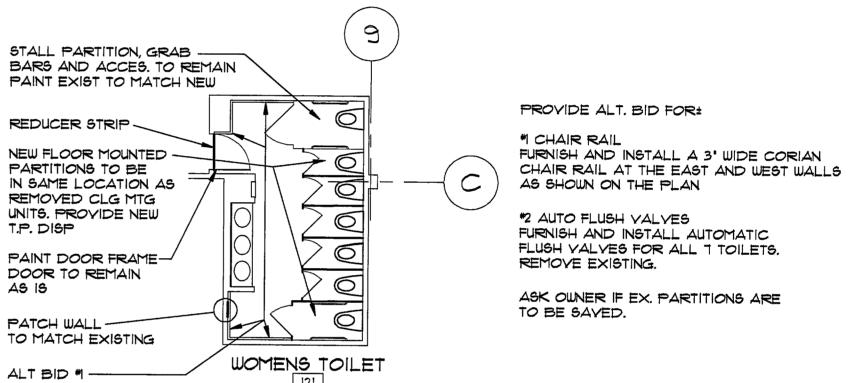

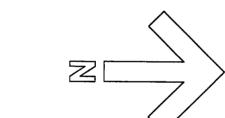




Architects Engineers

Construction Managers


205 W. HIGHLAND AVENUE
MILWAUKEE, WI 53203
FAX: 414/276-8448
PHONE: 414/276-8375

PROJI	ECT	
(	GUARANTY BANK	
	W BROWN DEER RO	AD
	WN DEER, WISCONSI	
PROII	ECT TYPE	
I(O)I	-CI IIIL	
EGEN	1DS	
F\/ISI	ONS	
DATE	DESCRIPTION	CON
1/26/99	GUARANTY BANK REVISIONS	
· · · · · · · · · · · · · · · · · · ·		+

R	EVIS	IONS		•
NO.	DATE	DESCRIPTION		CONST
$\triangle$	1/26/99	GUARANTY BA	NK REVISIONS	
	-			
<del>-</del>				
				,
S	HEET	CONT	ENTS	
FL	OOR PL	AN		
٨	1ISC.	INFO	SHEET	
	TE: OJECT NO.	11/13/98 98047	۸-	1

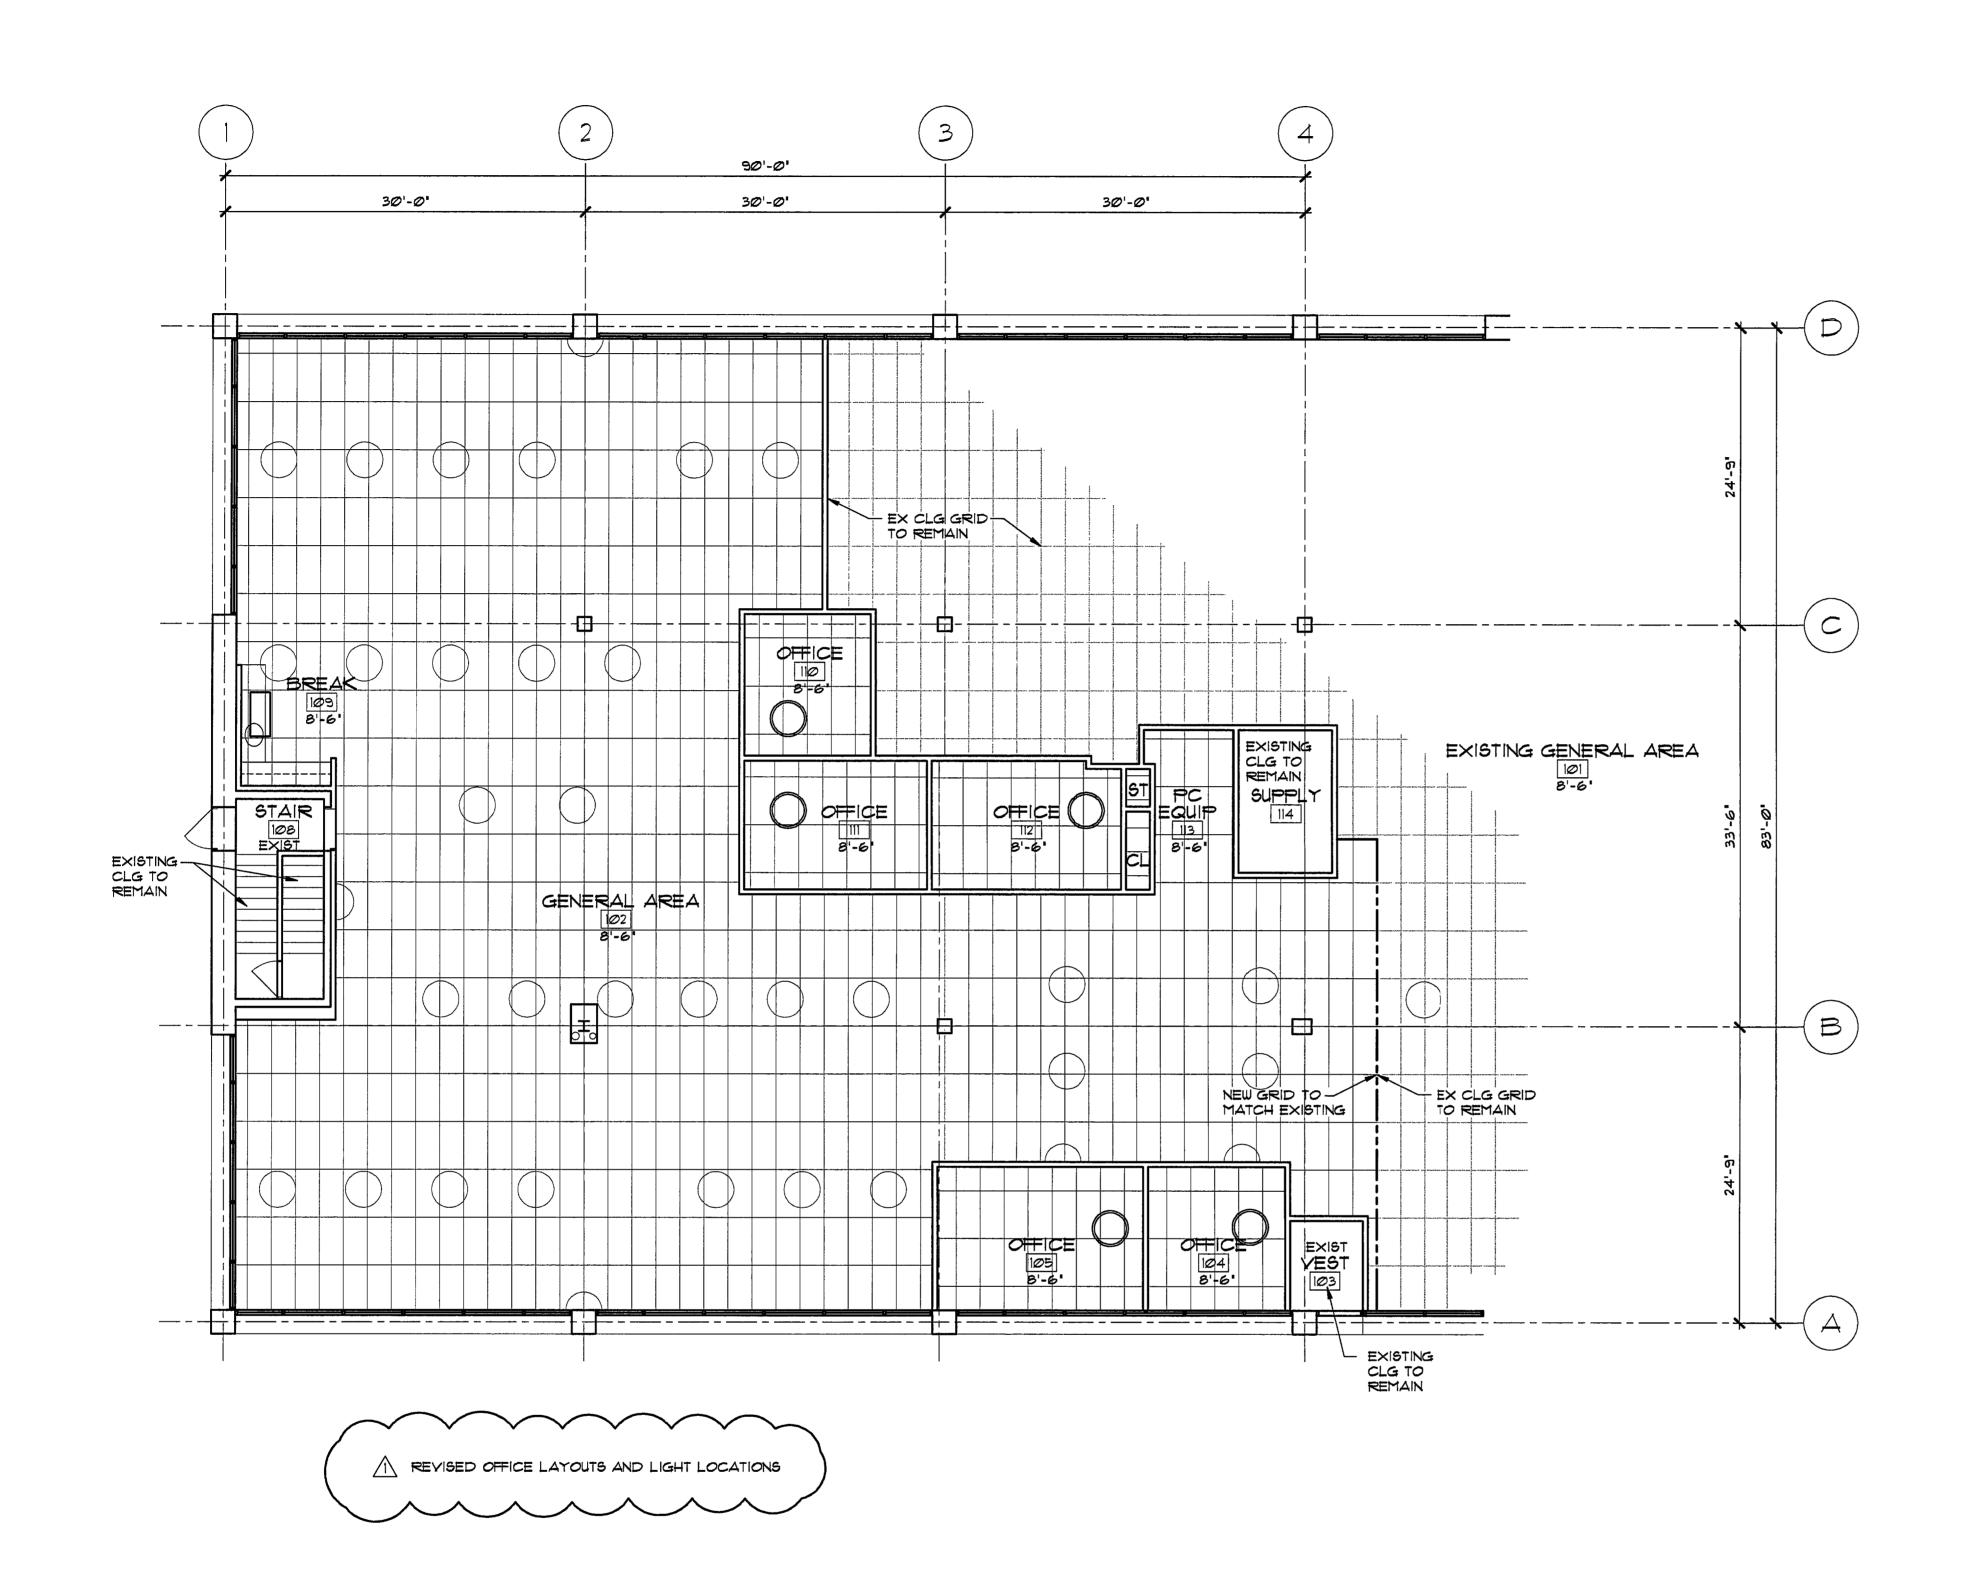





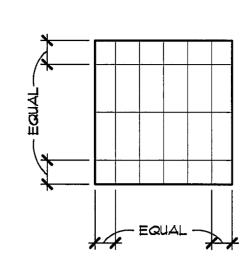

### TYP CLG GRID LAYOUT

1/8" = 1'-0"

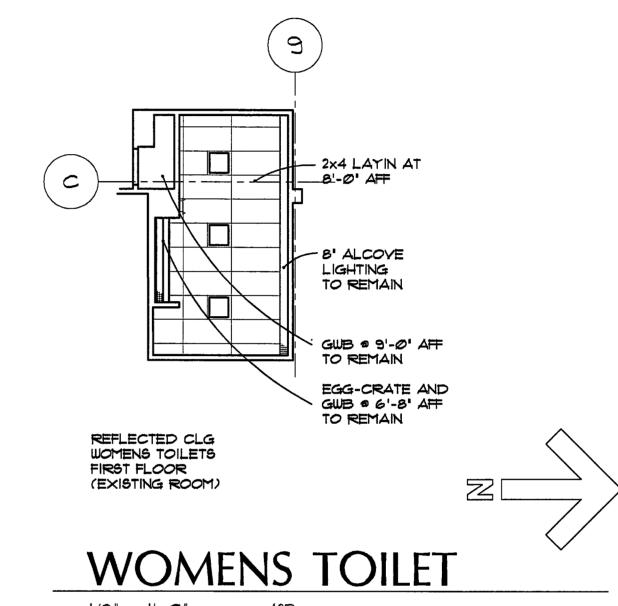

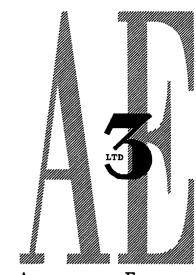

■ Construction Managers

205 W. Highland Avenue MILWAUKEE, WI 53203 414/276-8448 PHONE: 414/276-8375

### **PROJECT**

**GUARANTY BANK** 

4000 W BROWN DEER ROAD BROWN DEER, WISCONSIN

### PROJECT TYPE

### **LEGENDS**

COMMUNICATION OUTLET DUPLEX OUTLET

REMOVE & REUSE 2x4 FLUSH FLUOR IN 2x4 CLG GRID

SUPPLY GRILLES EXISTING CEILING TILE & GRID

CLG HEIGHT ROOM NO

LIGHTS SUPPLIED
BY OWNER, INSTALLED
BY CONTRACTOR
(FINAL LOCATION TO BE
DETERMINED AFTER FURNITURE
PLAN IS FINALIZED)


### **REVISIONS**

NO.	DATE	DESCRIPTION	CONST
$\triangle$	1/26/99	GUARANTY BANK REVISIONS	
S	HFFT	CONTENTS	
	· · · · · ·		


REFLECTED CEILING PLAN

MISC. INFO SHEET

11/13/98 PROJECT NO.

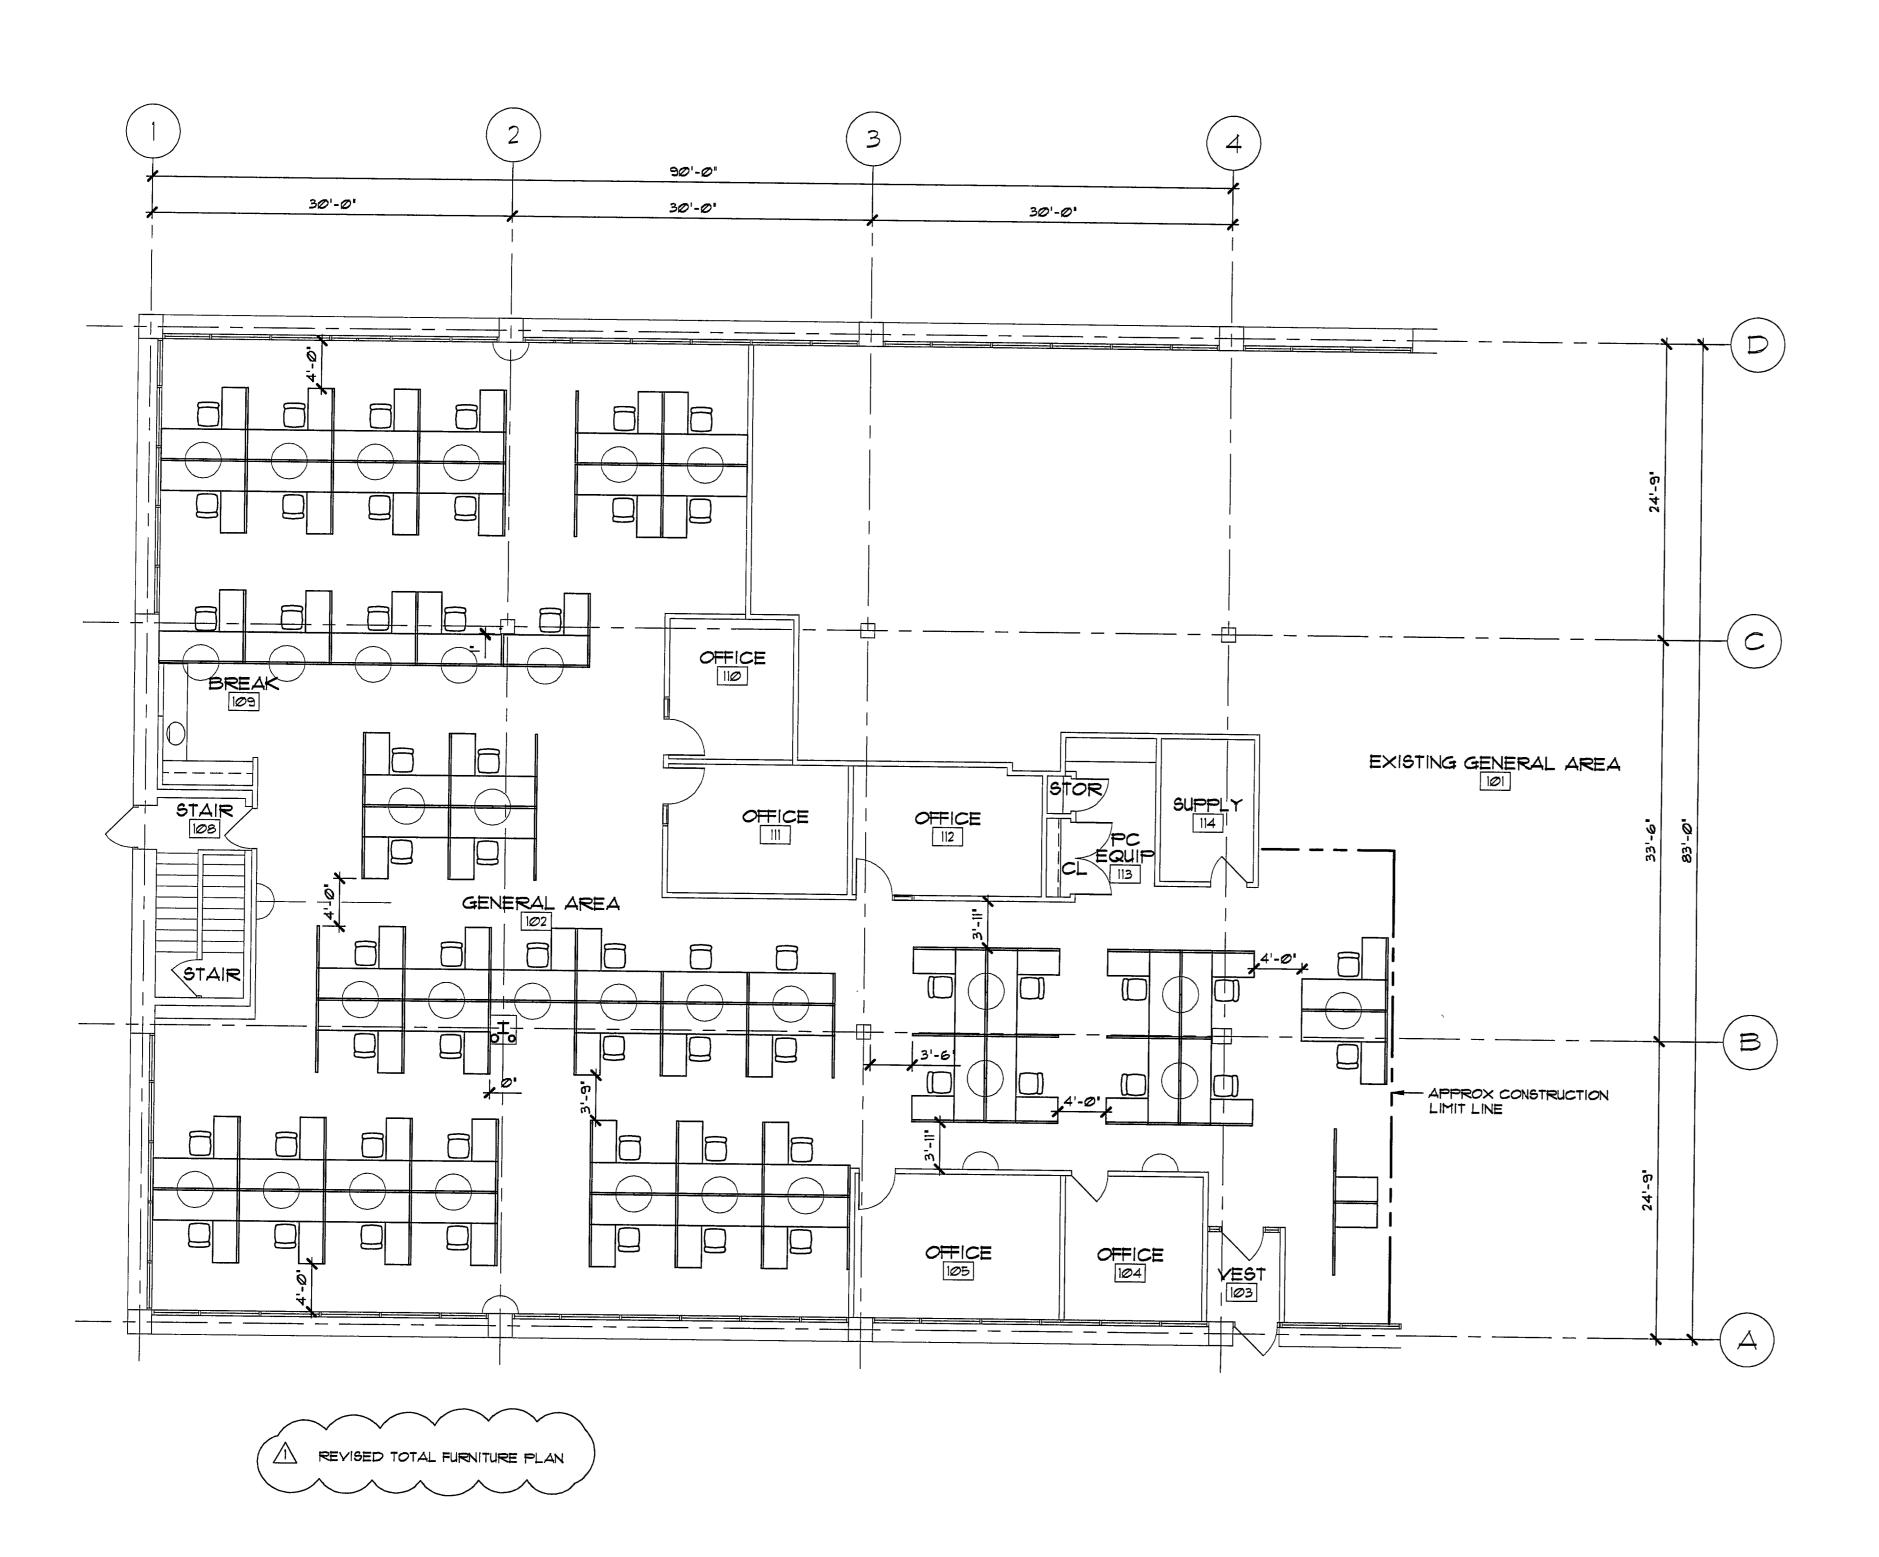




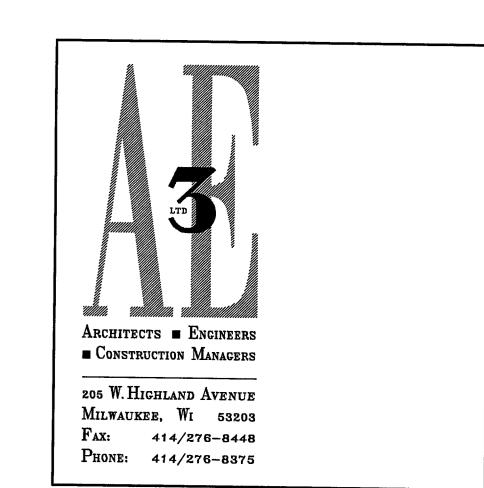


DDOILCT	
PROJECT	
	NTY BANK
BROWN DEER	VN DEER ROAD R, WISCONSIN
PROJECT TY	PE
LEGENDS	
REVISIONS	
NO. DATE DESCRIPTION	CONST
/1\ 1/26/99 GUARANTY E	BANK REVISIONS
CLIEET CONT	TEN ITC
SHEET CONT	ENIS
TOMITONE LEGIS	
MISC. INFO	SHEET


PROJECT NO. 98047

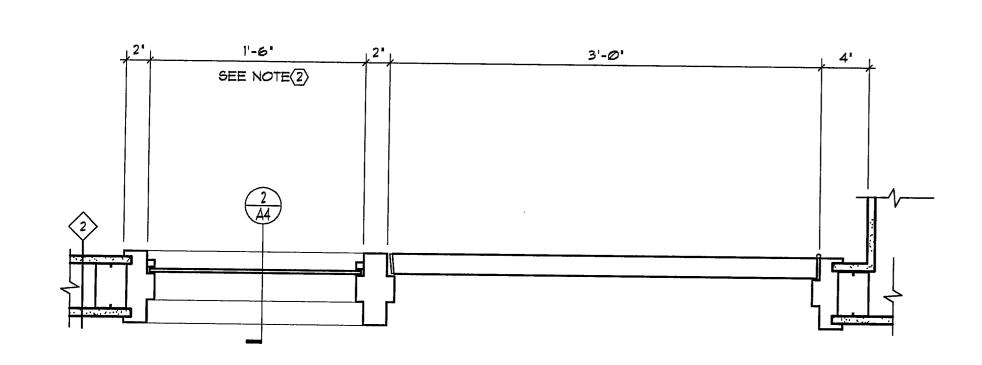

# HOLLOW METAL - DOOR @ SIDELIGHT

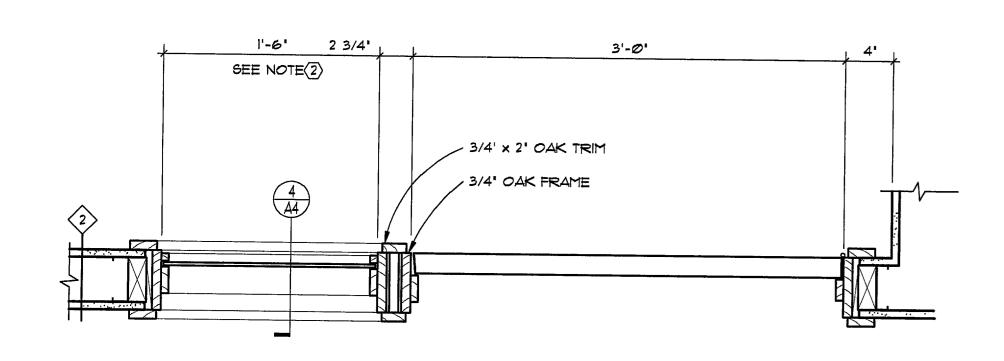


WOOD - DOOR @ SIDELIGHT

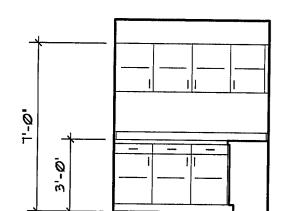


REMOVE EXISTING CABINETS. PROVIDE NEW LAM PLASTIC FINISHED (ALL SURFACES) CABINETS WITH PLASTIC PULLS, TRICOVE TOP AND CONCEALED HINGES


EL OF W WALL - BREAK ROOM 109

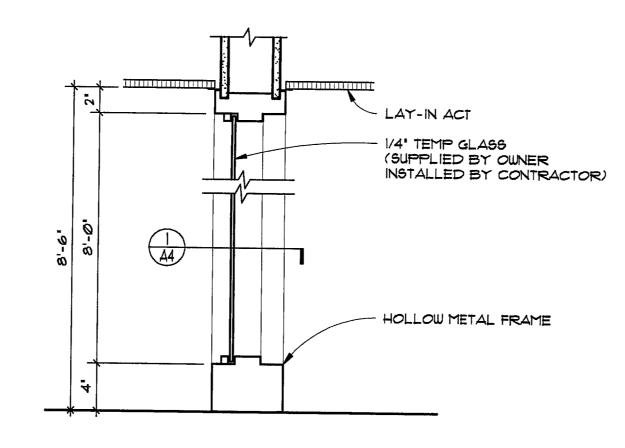

SECTION @ HM SIDELIGHT

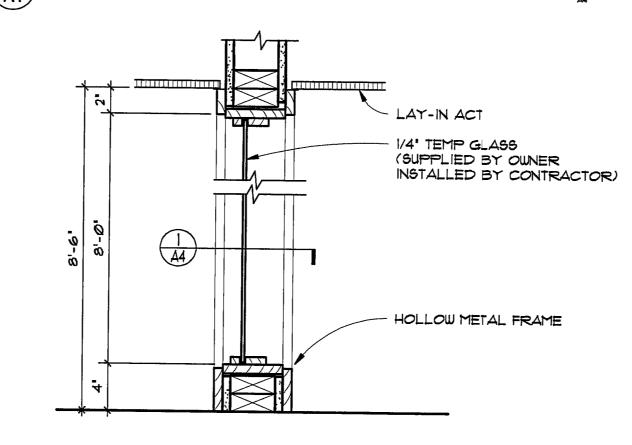

SECTION @ WOOD SIDELIGHT

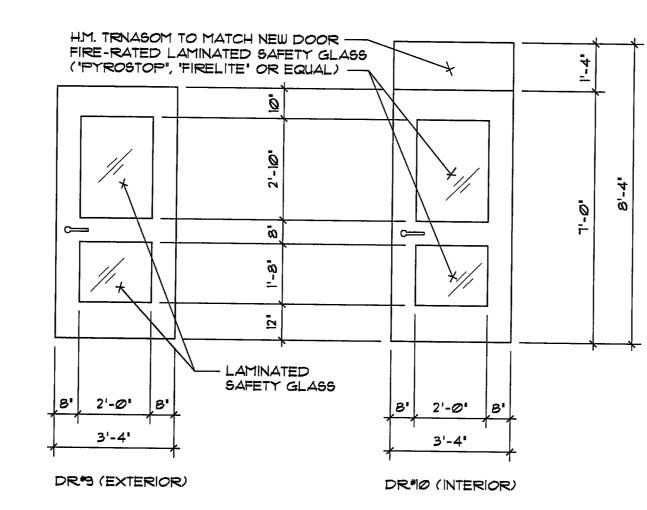

6 NEW DOORS @ NOS. 9 & 10

			RO	OM FI	NISH	SCHE	DULE	3		
NO.	ROOM NAME	FLOOR	BASE	NORTH	EAST	SOUTH	WEST	CLG.	CLG. HT.	REMARKS
101	EXIST GENERAL AREA	EXIST	EXIST	EXIST	EXIST	EXIST	EXIST	EXIST	EXIST	
102	GENERAL AREA	CARPET	VINYL	GWB/PT	GWB/PT	GWB/PT	GWB/PT	ACT	8'-6'	2
103	VESTIBULE	YCT	VINYL	EXIST	EXIST	EXIST	EXIST	EXIST	EXIST	В
104	OFFICE	CARPET	VINYL	VWC	YWC	YUC	VUC	ACT	8'-6"	
105	OFFICE	CARPET	YINYL	VWC	YWC	VWC	YWC	ACT	8'-6"	
106	CLOSET	CARPET	VINYL	YWC	YWC	YWC	VIIC	ACT	8'-6'	
107	STAIR	EXIST	EXIST	EXIST	EXIST	EXIST	EXIST	EXIST	EXIST	
108	STAIR	YCT	YINLY	EXIST	EXIST	EXIST	EXIST	EXIST	EXIST	8
109	BREAK	YCT	VINYL	YWC	YWC	YWC	VWC	ACT	8'-6'	
110	OFFICE	CARPET	VINYL	YWC	YWC	YUC	VWC	ACT	8'-6'	
111	OFFICE	CARPET	VINYL	YWC	YWC	VIIC	VWC	ACT	8'-6'	
112	OFFICE	CARPET	VINYL	YWC	YWC	YWC	MAC	ACT	8'-6'	
113	PC EQUIPMENT	EXIST	EXIST	EXIST	EXIST	EXIST	EXIST	EXIST	EXIST	
114	SUPPLY	EXIST	EXIST	EXIST	EXIST	EXIST	EXIST	EXIST	EXIST	
115	NA								27(101	
116-12	0 4	EXIST	EXIST	EXIST	EXIST	EXIST	EXIST	EXIST	EXIST	
121	WOMENS TOILET	5	5	6	6	6	6	<u> </u>	7	

- EXISTING GENERAL AREA. WORK THIS AREA NIC UNLESS OTHERWISE NOTED, OR REQUIRED TO FINISH CONTRACT WORK.
- GENERAL AREA. WORK THIS AREA TO MATCH EXISTING GENERAL AREA UNLESS OTHERWISE NOTED.
- ALL MATERIALS, FINISHES, ETC. TO MATCH EXISTING UNLESS OTHERWISE NOTED. EXISTING ROOM - NIC
- REMOVE EXISTING CERAMIC TILE FLOOR & BASE, PROVIDE 12x12 TILE FLOOR AND BASE TO MATCH LOBBY
- REMOVE EXISTING YWC, PROVIDE NEW YWC ON E, S, & W WALLS. CERAMIC TILE ON NORTH WALL TO REMAIN AS IS. PATCH AS REQUIRED WHERE PARTITIONS WHERE REMOVED OR AS NEEDED DUE TO NEW CONSTRUCTION.
- REMOVE EXISTING 2x4 CEILING ® 8'-Ø" AFF. PROVIDE NEW 2x4 ® 8'-Ø". SEE REFL CLG PLAN FOR MORE INFO.
- B NEW VINYL TILE BETWEEN DOORS OT & 08 (MARLEY MPC 51 EBONY ATLANTA)

DR.		DOOR	<b>4</b>				FRAME			
NO.	SIZE	TYPE	MATERIAL	GL/SIDELT	GRILL	FINISH	TYPE	MATERIAL	DETAIL	REMARKS
01	EXIST	<b>(8)</b>	EXIST	EXIST	EXIST	EXIST	EXIST	EXIST	EXIST	NIC
<b>Ø</b> 2	EXIST	<b>(3</b> )	EXIST	EXIST	EXIST	EXIST	EXIST	EXIST	EXIST	NIC
Ø3	3'-0'x8'-4'x1 3/4'	FLUSH	SC WOOD	NA	NA	SEY	A		NA	
<b>Ø</b> 4	3'-0'x8'-4'x  3/4'	FLUȘH	SC WOOD	NA	NA	SŧY	A	(1)	NA NA	
Ø5	(2) 3'-0'x8'-4'x1 3/4"	FLUSH	SC WOOD	NA	NA	SŧV	A		NΑ	
06	EXIST	EXIST	EXIST	EXIST	EXIST	EXIST	EXIST	EXIST	EXIST	NIC
Ø7	3'-4'x7'-Ø'xi 3/4'	FLUSH	H.M.	( <del>5</del> )	NA	6	EXIST	EXIST	6/A4	EXTERIOR
08	3'-4'x8'-4'x1 3/4"	FLUSH	н.м.	<b>(5)</b>	NA	(6)	EXIST	EXIST	6/44	1 1/2 HR (T
Ø9	3'-@'x8'-4'x  3/4"	FLUSH	SC WOOD	2	NA	SAY	A		1 OR 3/A4	
10	3'-@'x8'-4'x1 3/4"	FLUSH	SC WOOD	2	NΑ	SAY	A	1	1 OR 3/A4	
11	3'-@'x8'-4'x  3/4'	FLUSH	SC WOOD	(2)	NΑ	SŧY	A	Ō	1 OR 3/A4	
12	EXIST	4	E×IST	EXIST	EXIST	EXIST	EXIST	6	EXIST	<del> </del>
13	2'-10'x8'-4'x1 3/4"	FLUSH	SC WOOD	NA	NA	547	A	(1)	NA NA	
4-21	EXIST	EXIST	EXIST	EXIST	EXIST	EXIST	EXIST	EXIST	EXIST	NIC

(1) CONTRACTOR MAY SUPPLY AND (3) ALL WOOD BLOKING TO INSTALL HOLLOW METAL OR WOOD FRAMES.


5 SEE DETAIL 6/A4

(7) I 1/2 HR RATED HARDWARE


(2) 1'-6' SIDELIGHT MAY YARY. CONFIRM SIZE OF OWNER FUNISHED SUPPLY NEW HARDWARE GLASS BEFORE BUILDING FRAME

BE FIRE RETARDANT 4) REUSE ALL EXISTING OAK DOORS. 6) PRIME & PAINT TO MATCH (8) NEW DOOR TO GC TO REPAIR AND REFINISH, AND EXISTING FRAME MATCH EXISTING MATCH EXISTING REUSE HOWE

REVISED ROOM & DOOR SCHEDULES

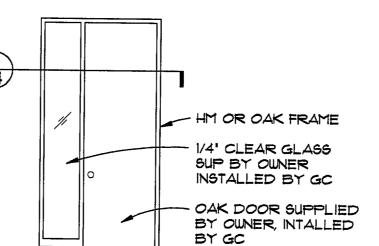

FRAME TYPE A

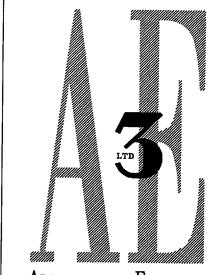

ARCHITECTS ENGINEERS ■ Construction Managers

205 W. Highland Avenue MILWAUKEE, WI 53203 FAX: 414/276-8448 PHONE: 414/276-8375

### **PROJECT**

**GUARANTY BANK** 4000 W BROWN DEER ROAD BROWN DEER, WISCONSIN

### PROJECT TYPE

### **LEGENDS**

NO.	DATE	DESCRIPTION	CONS
$\triangle$	1/26/99	GUARANTY BANK REVISIONS	
· · · · · · · · · · · · · · · · · · ·			

### SHEET CONTENTS

ROOM FINISH SCHEDULE DOOR SCHEDULE **DETAILS** 

MISC. INFO DATE: PROJECT NO.

11/13/98 98047