



- ★ SEE COMMENTS
- ★ SEP. ELE, PLMB, & HVAC PERMITS REQ'D.
- ★ SEE HARD CARD FOR REQ'D INSPECTIONS


Roger and Ann Rathert Residence
5313 W. Donna Drive Brown Deer, WI 53223



SAZAMA
■ DESIGN ■ BUILD


Carl Holtermann, Design & Project Coordinator Cell: 262 993-6323 6027 W. Vliet Street Wauwatosa WI 53212

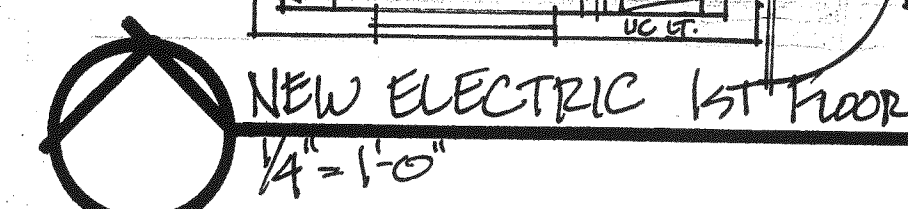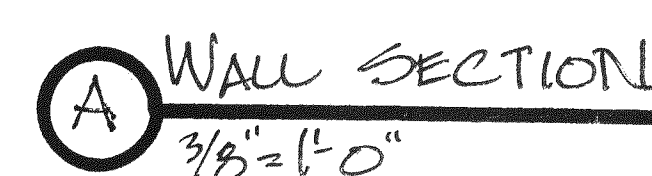

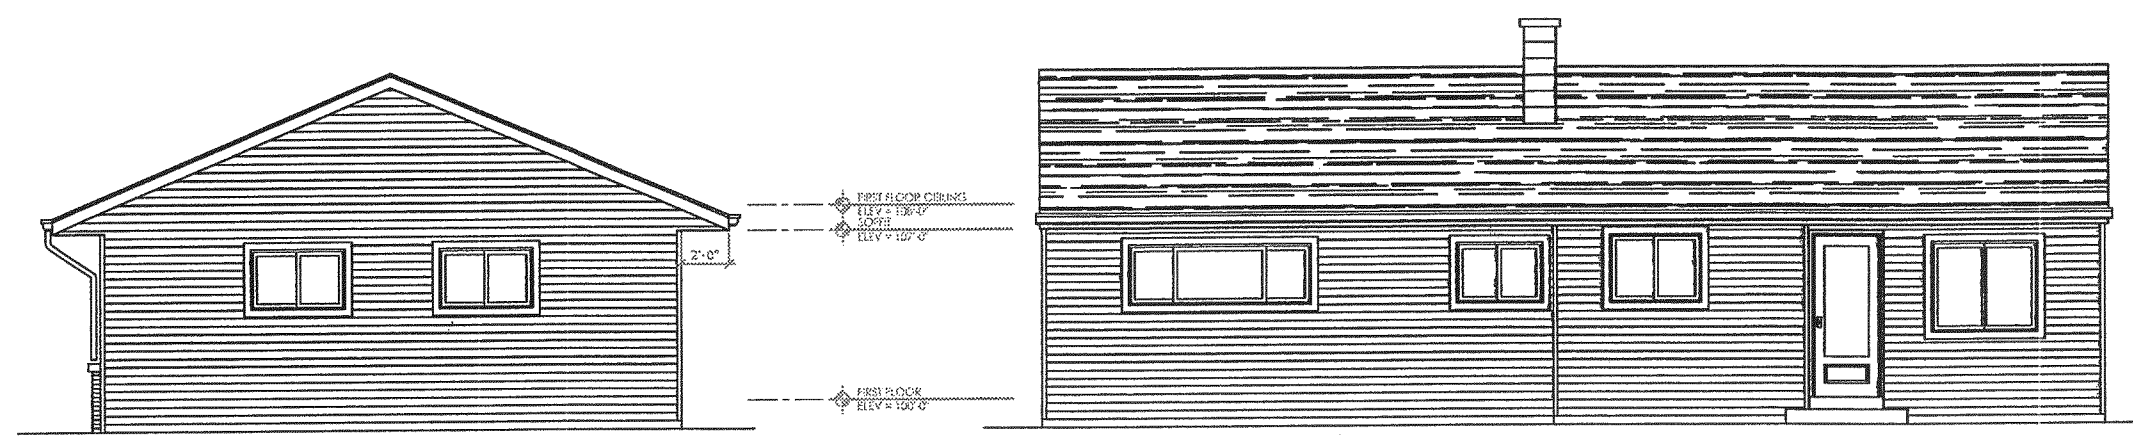


1 WEST ELEVATION
SCALE: 1/4" = 1'-0"

2 SOUTH ELEVATION
SCALE: 1/4" = 1'-0"

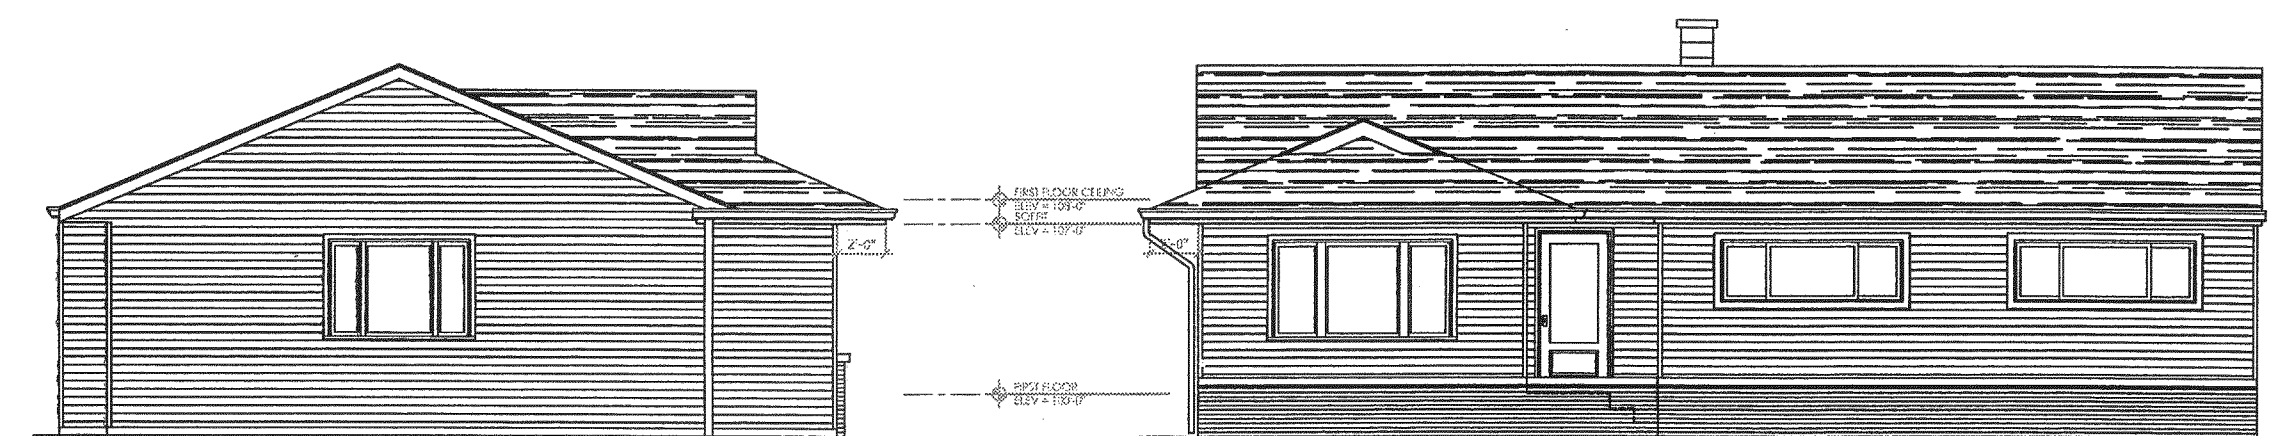

3 EAST ELEVATION
SCALE: 1/4" = 1'-0"

4 NORTH ELEVATION
SCALE: 1/4" = 1'-0"

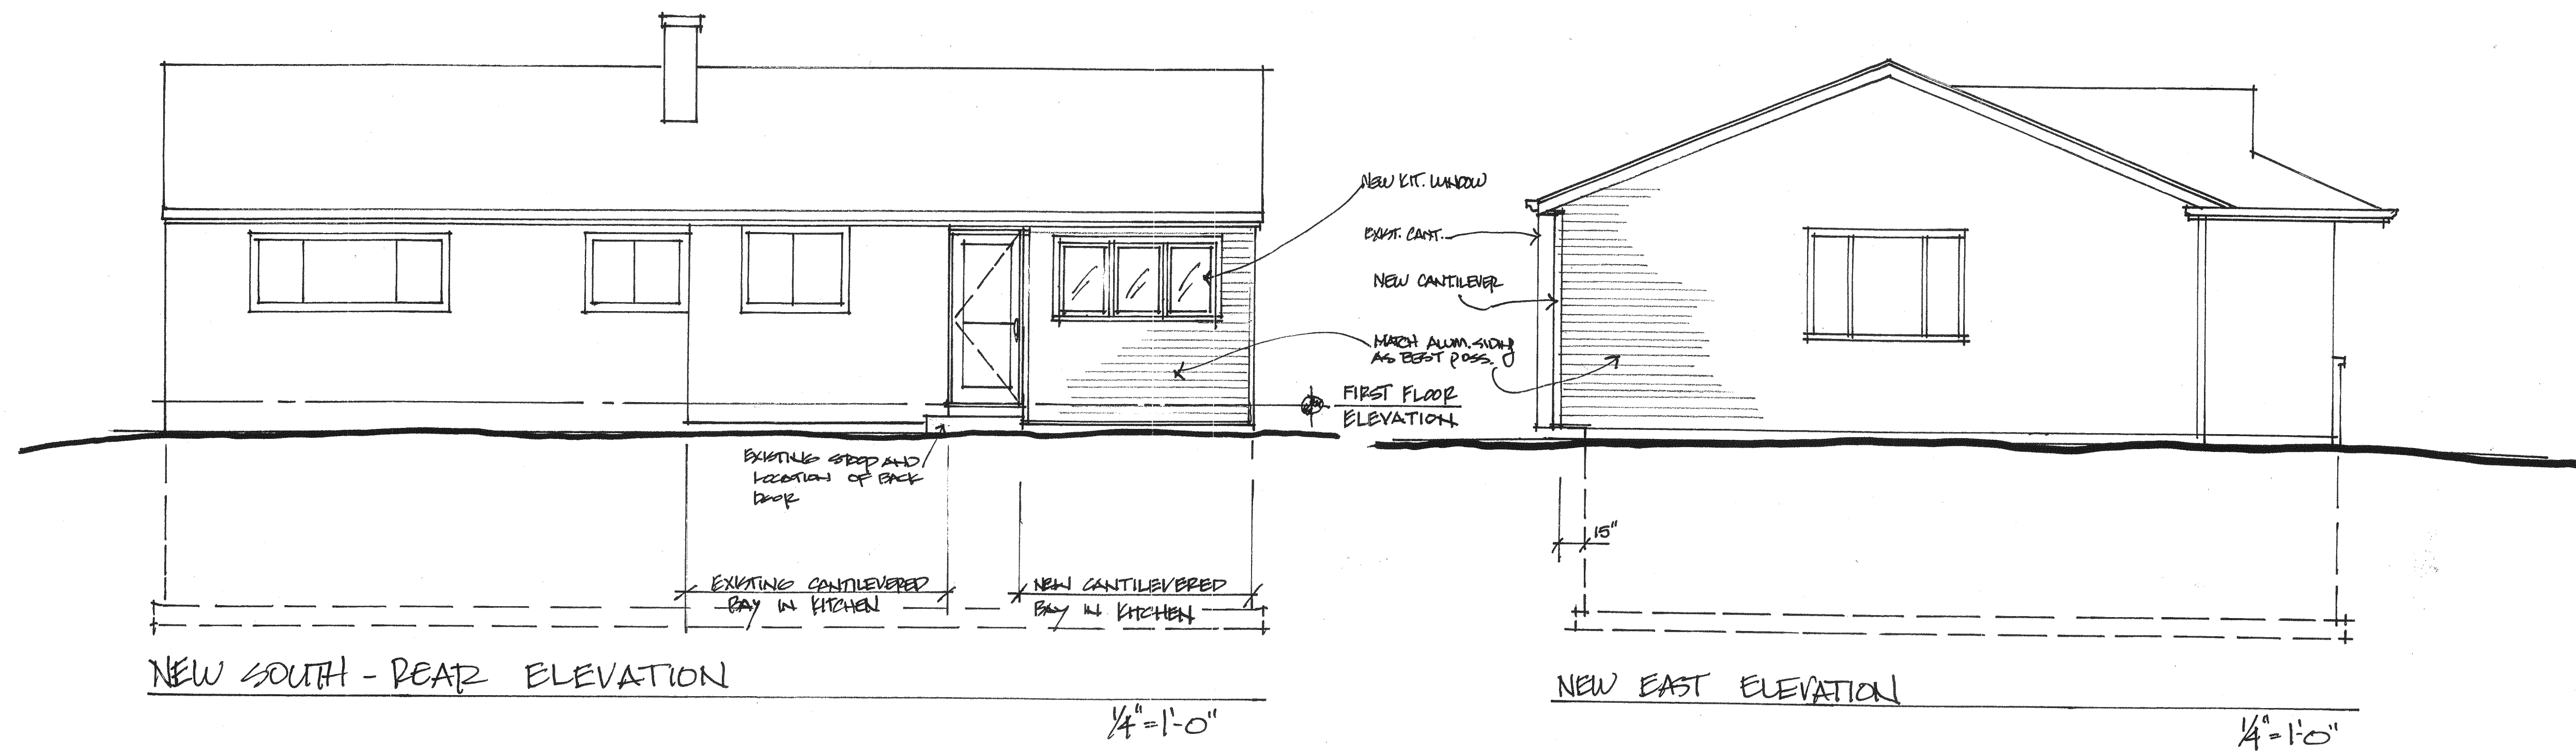

NEW SOUTH - REAR ELEVATION

1/4" = 1'-0"

NEW EAST ELEVATION

1/4" = 1'-0"

REMODEL EXISTING
ROOF

FROM GABLE
TO HIP END

REPAIR OR
REPLACE WINDOW

ROOF REMODELING
ALL WORK TO MATCH
EXISTING

APPROVED

Village Brown Deer
Building Board

Date 6/17/74

6-17-74




REMODELING WORK
ROOF AND WINDOW
5313 W. DONNA DRIVE

RICHARD G COOK RESIDENCE




DESIGN GROUP


COOK ASSOCIATES

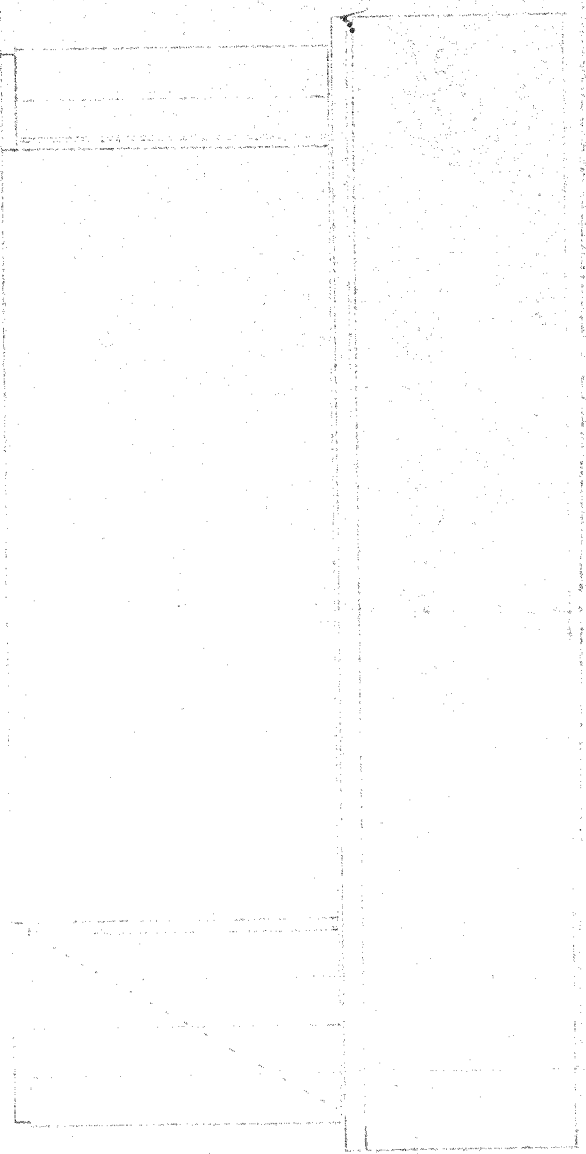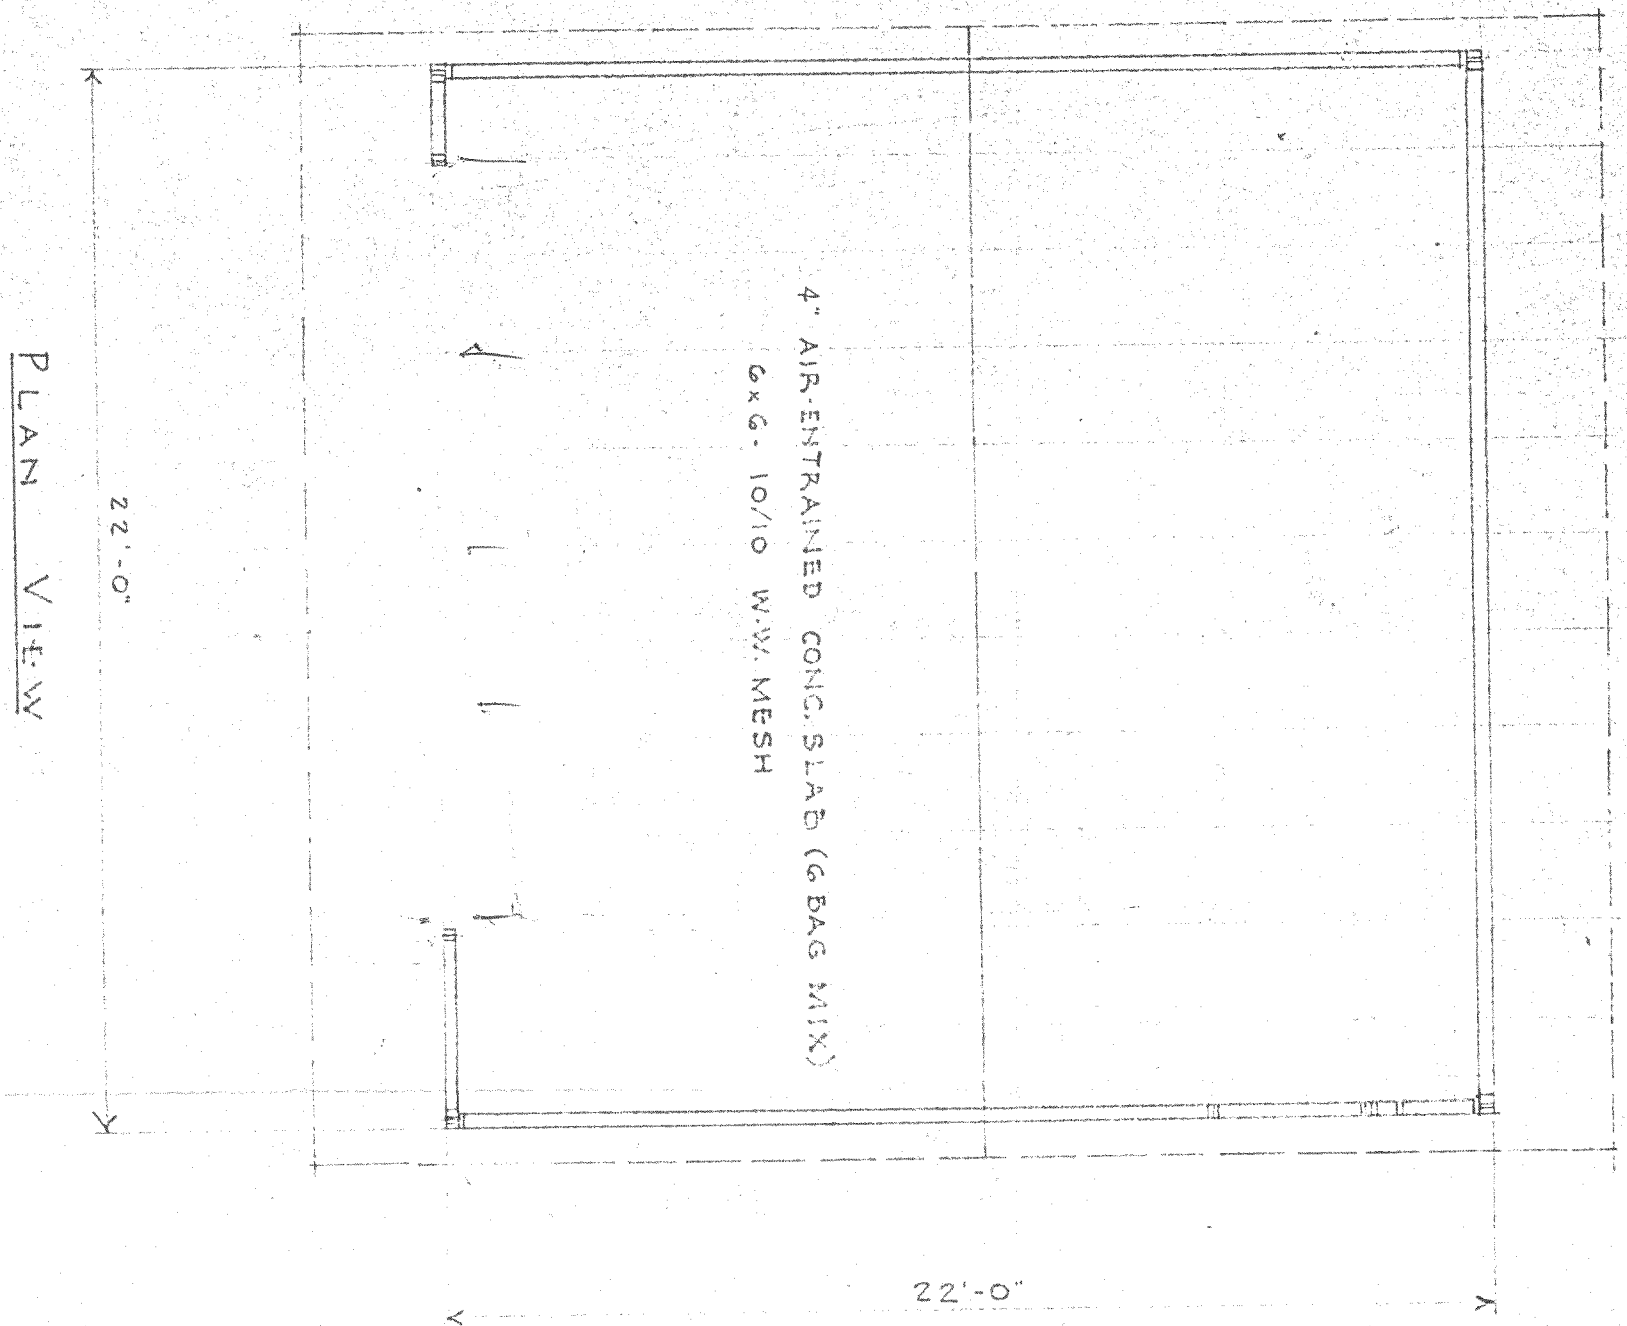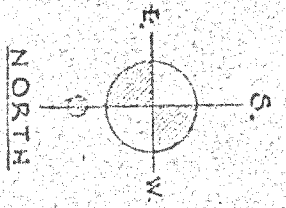



NORTH ELEVATION

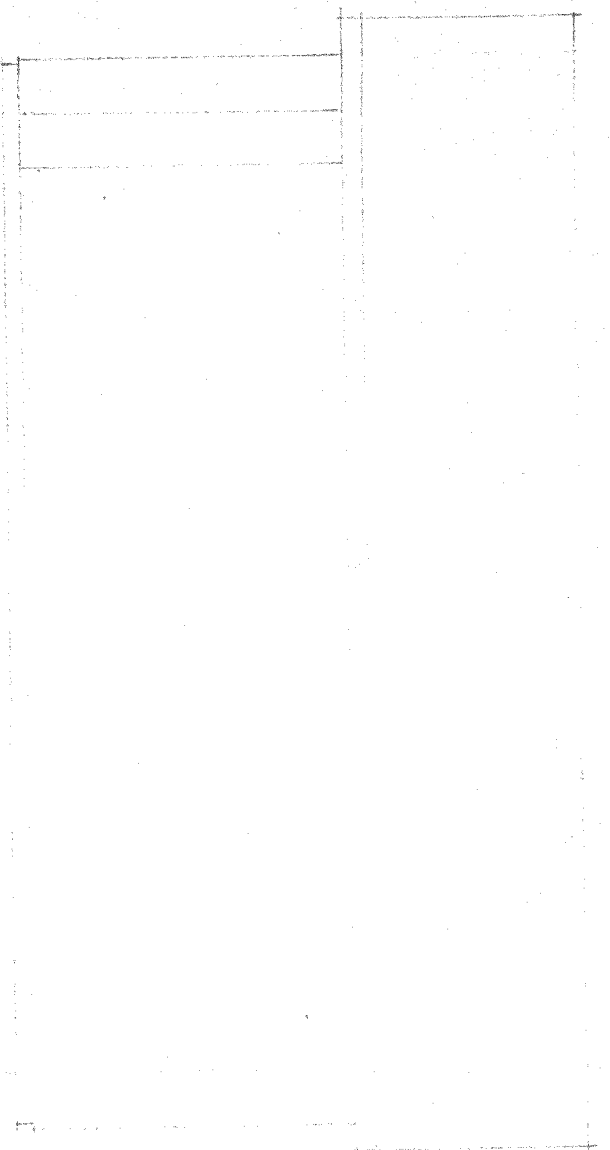


SOUTH ELEVATION

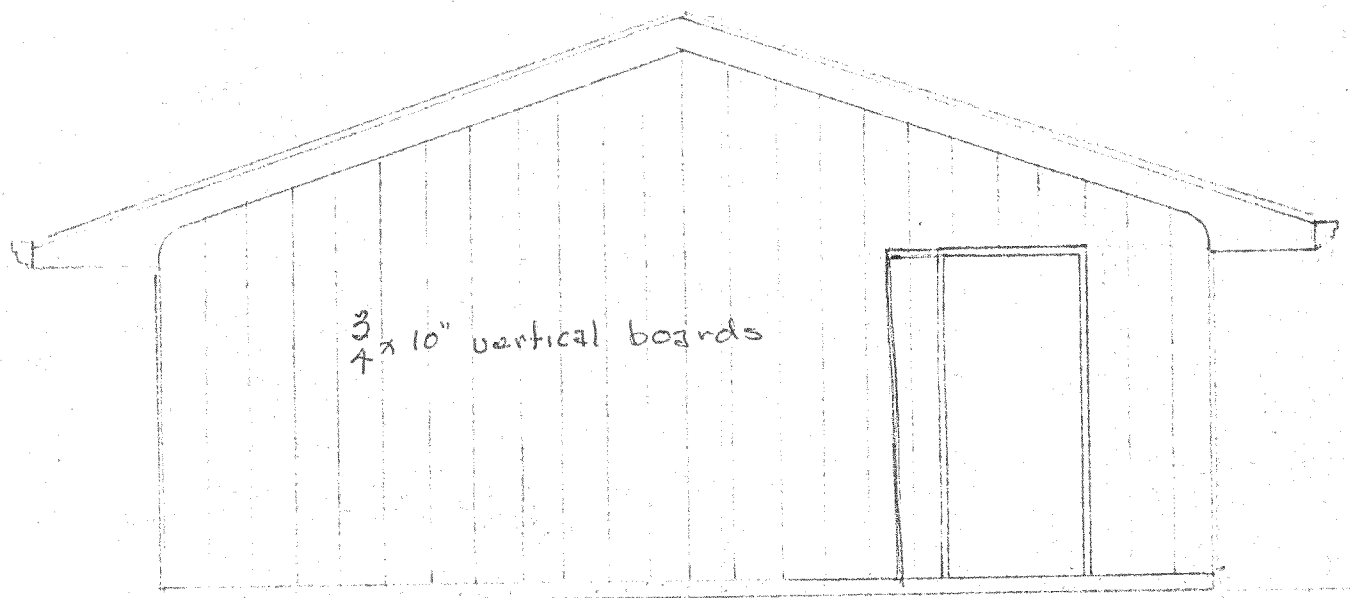

EAST ELEVATION

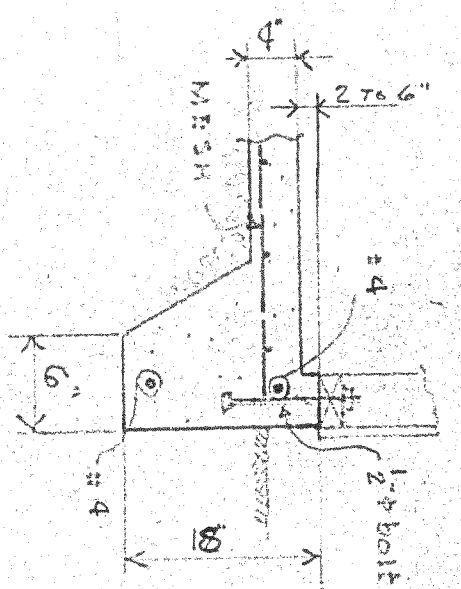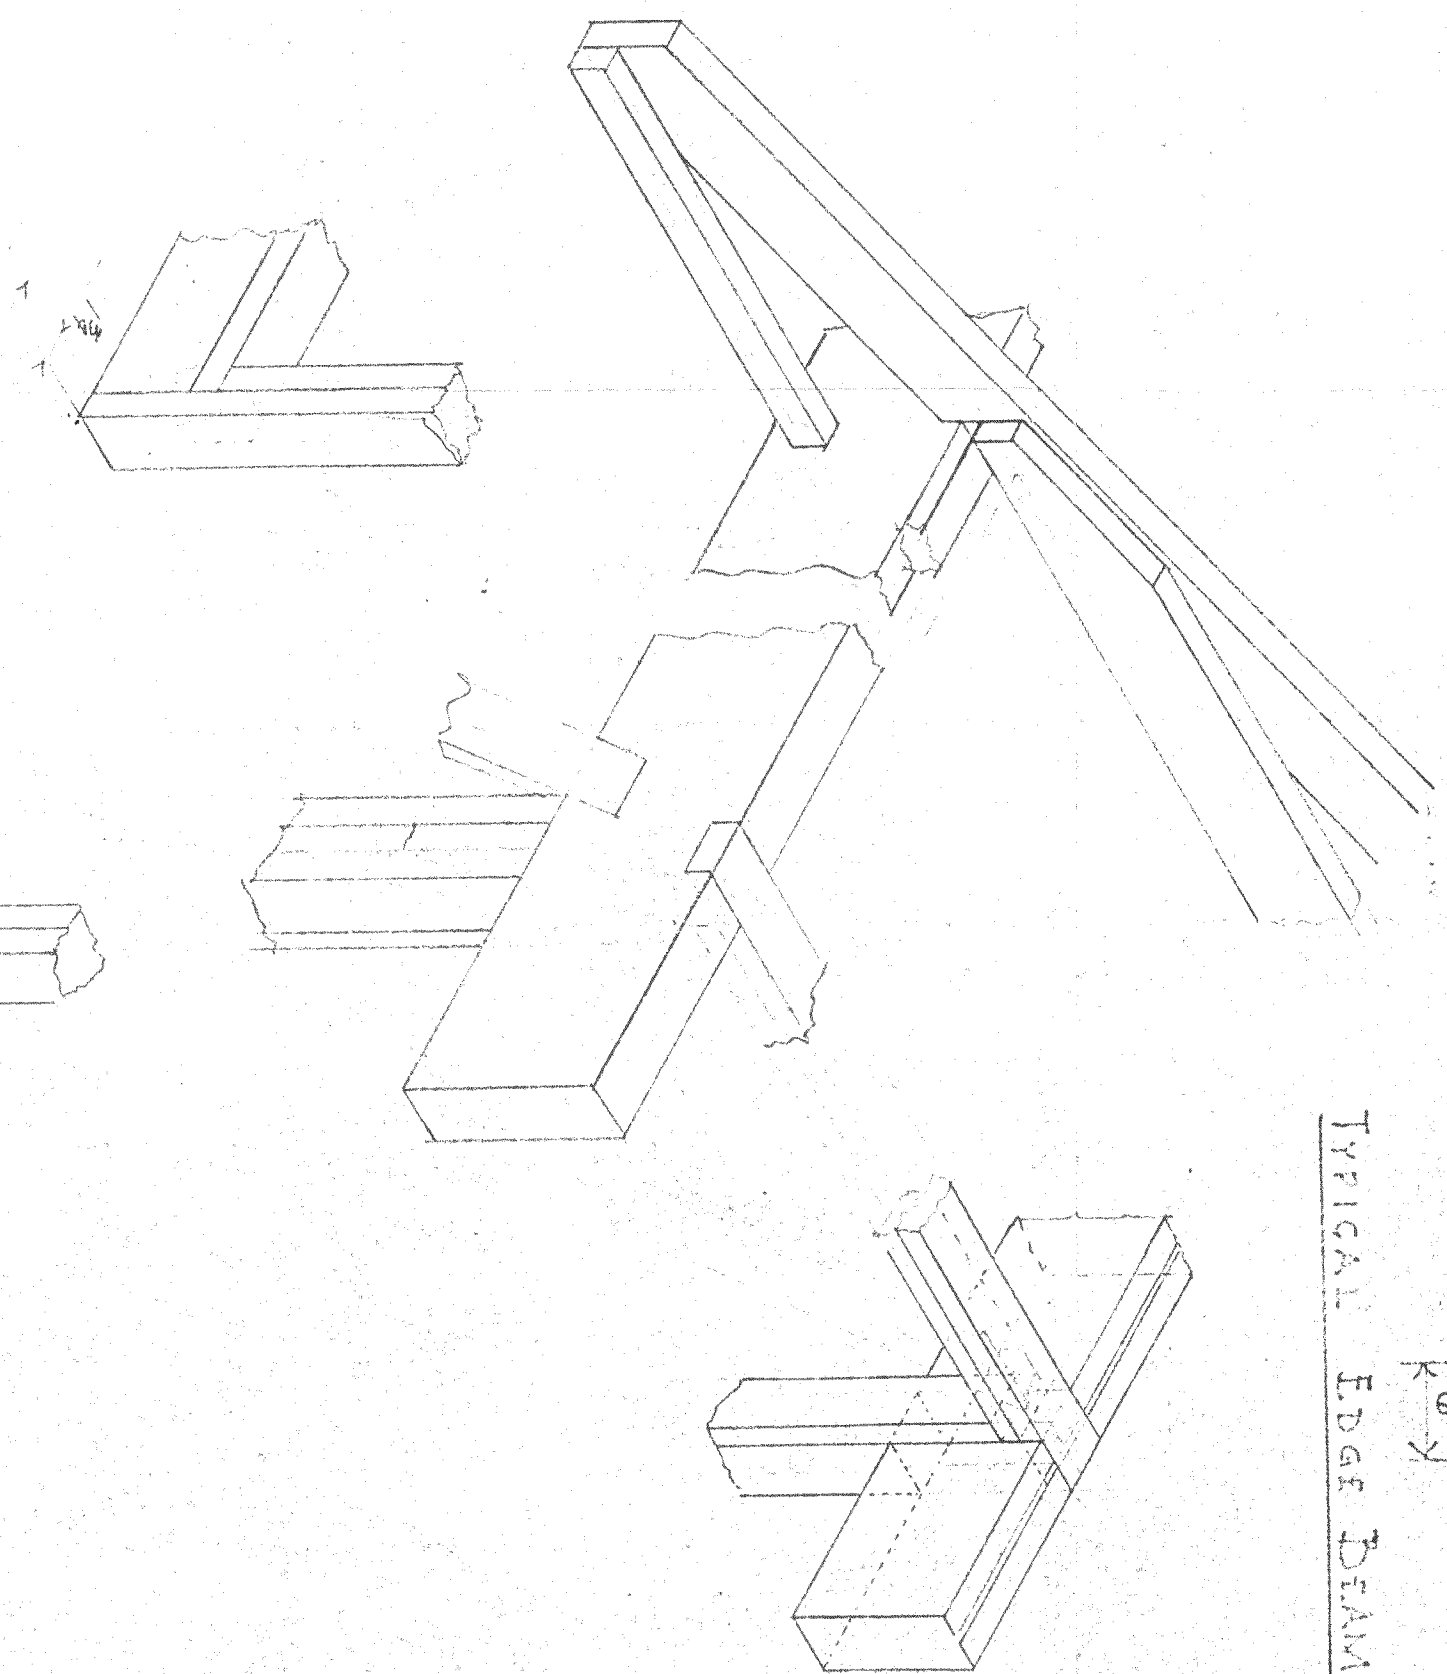

TYPICAL EDGE BEAM

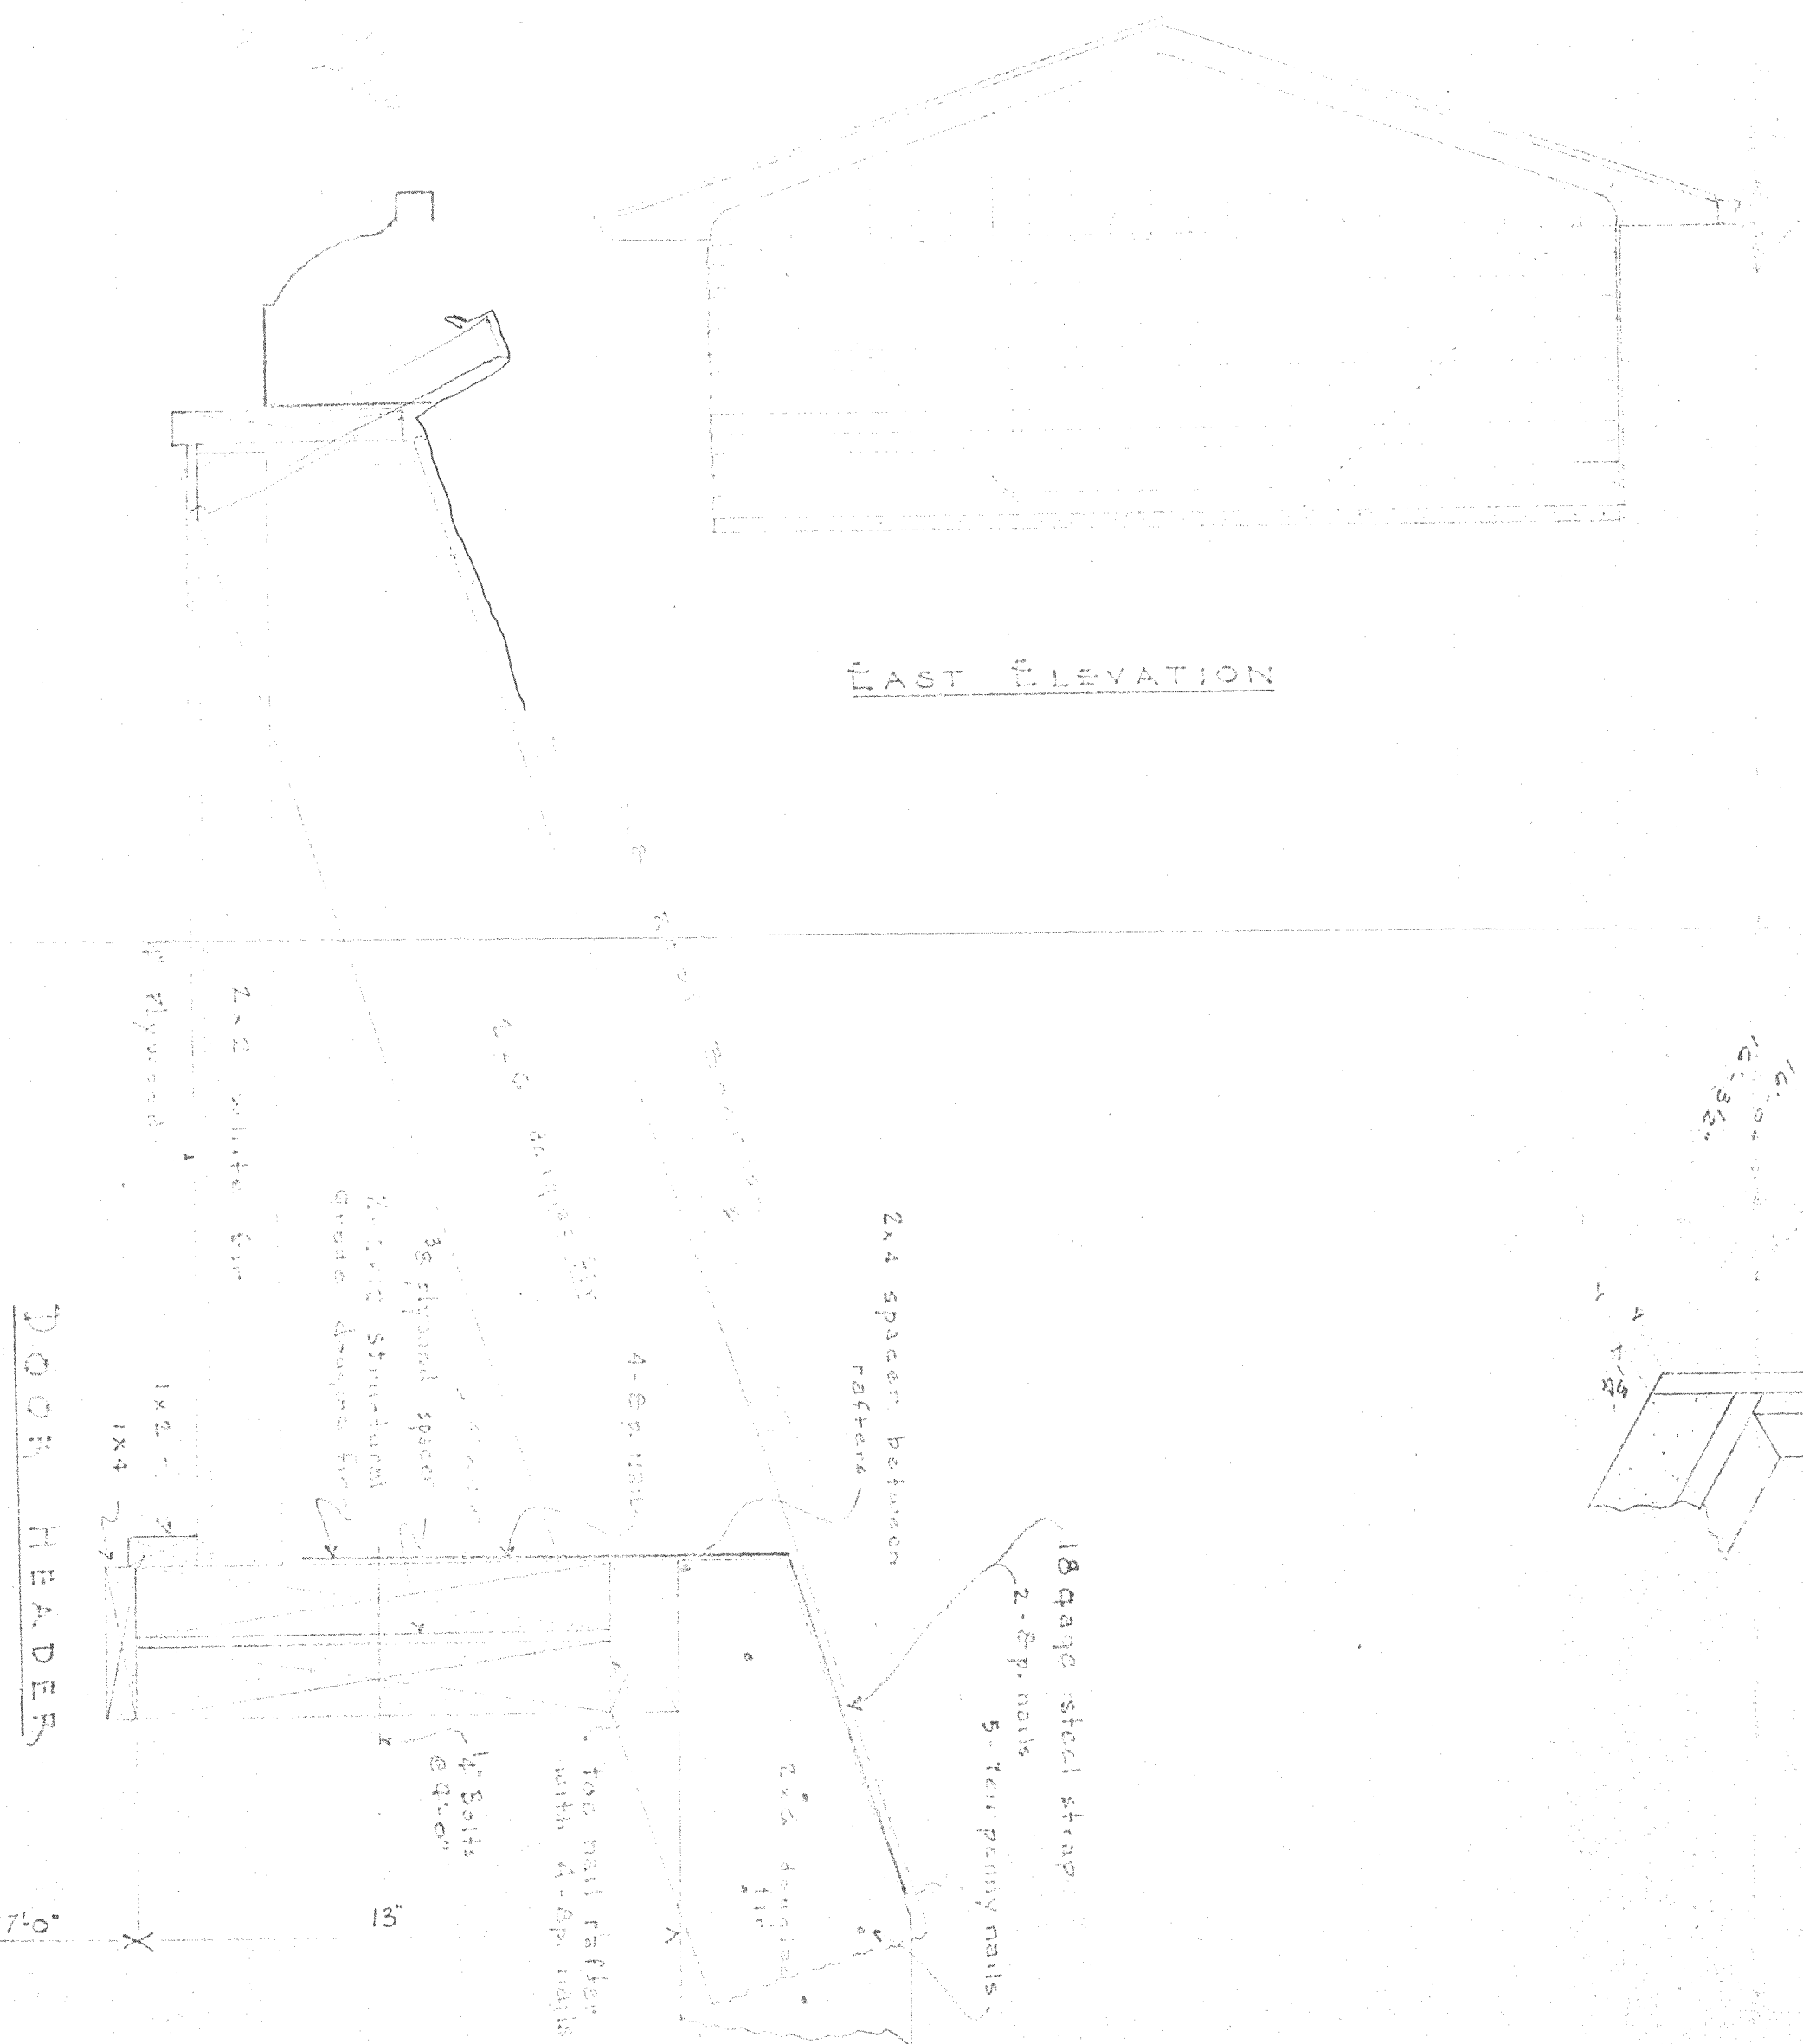

DOOR HEADER

All lumber kiln dried - header to be 2x12. Structural grade dougls fir

Richard G. Cook
5313 W BUNN DR



1/2
1/4
1/8
1/16

